CR-24-323 Agency Index CORNER RECORD **Document Number** , California County of SAN JOAQUIN **STOCKTON** City of Brief Legal Description FOUND MONUMENTS NEAR THE SOUTH WEST CORNER OF CENTER STREET AND JEFFERSON STREET PER CORNER RECORD 24-118, SAN JOAQUIN COUNTY SURVEYOR'S RECORDS. **COORDINATES (Optional) CORNER TYPE** E. Elevation Government Corner Control X Property X U.S. Survey Foot Units Metric Meander SEC 9 Other Rancho Horizontal Datum **Epoch Date** Zone February 10, 2023 Date of Survey Vertical Datum Complies with Public Resources Code §§8801-8819 C.M. WEBER GRANT Complies with Public Resources Code §§8890-8902 X 8771 8773 Other: PLS Act Ref.: 8765(d) Pre-Construction Rebuilt Left as found Established Corner/ Monument: X Post-Construction Referenced Reestablished Found and tagged Narrative of corner identified and monument as found, set, reset, replaced, or removed: See sheet #2 for description(s): SURVEYOR'S STATEMENT

This Corner Record was prepared by me or under my direction in conformance with

the Professional Land Surveyors' Act on

March 22, 2024

Signed

P.L.S. or R.C.E. No.

8489



COUNTY SURVEYOR'S STATEMENT

This Corner Record was received

August 22, 2024

and examined and filed

Signed


September 6, 2024.

Hat P.L.S. OFR.C.E. No. 8657

Title

County Surveyor's Comment



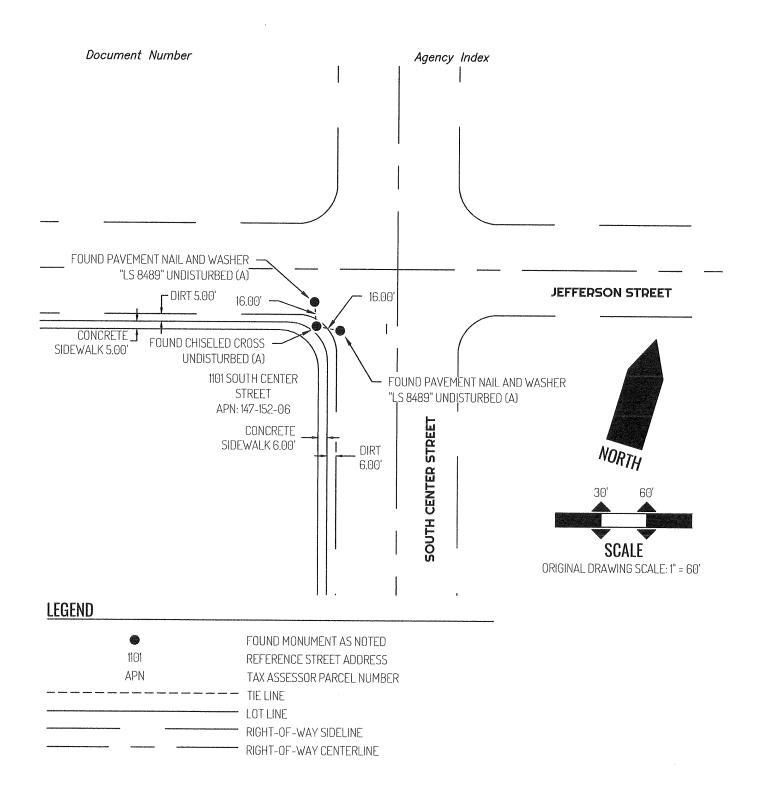

REFERENCE

(A) CORNER RECORD 24-118, SAN JOAQUIN COUNTY SURVEYOR'S RECORDS