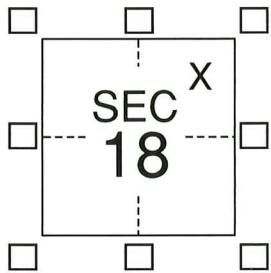


CORNER RECORD

Agency Index CR-25-082

Document Number _____

City of STOCKTON County of SAN JOAQUIN, CaliforniaBrief Legal Description LOT 2 OF BOOK 40 MAPS & PLATS PAGE 83.**CORNER TYPE**

Government Corner ☐ Control ☐
Meander ☐ Property ☒
Rancho ☐ Other ☐

Date of Survey December 30, 2024**COORDINATES (Optional)**

N. _____ E. _____

Elevation _____

Units Metric ☐ U.S. Survey Foot ☒

Horizontal Datum _____

Zone _____ Epoch Date _____

Vertical Datum _____

☐ Complies with Public Resources Code §§8801-8819☐ Complies with Public Resources Code §§8890-8902PLS Act Ref.: ☐ 8765(d) ☒ 8771 ☐ 8773 ☐ Other:

Corner/
Monument: ☐ Left as found ☐ Established ☐ Rebuilt ☐ Pre-Construction
☐ Found and tagged ☒ Reestablished ☐ Referenced ☒ Post-Construction

Narrative of corner identified and monument as found, set, reset, replaced, or removed:

☒ See sheet #2 for description(s):

THE PURPOSE OF THIS CORNER RECORD IS TO REPLACE THE RIGHT-OF-WAY MONUMENT REMOVED DURING P.G. & E. CONSTRUCTION ACTIVITIES.


SURVEYOR'S STATEMENT

This Corner Record was prepared by me or under my direction in conformance with

the Professional Land Surveyors' Act on January 6, 2025.Signed Ronald E. Monsour (P.L.S.) or R.C.E. No. 8474**COUNTY SURVEYOR'S STATEMENT**This Corner Record was received March 3, 2025and examined and filed March 13, 2025.Signed James E. Hart P.L.S. or R.C.E. No. 8657Title County Surveyor

County Surveyor's Comment

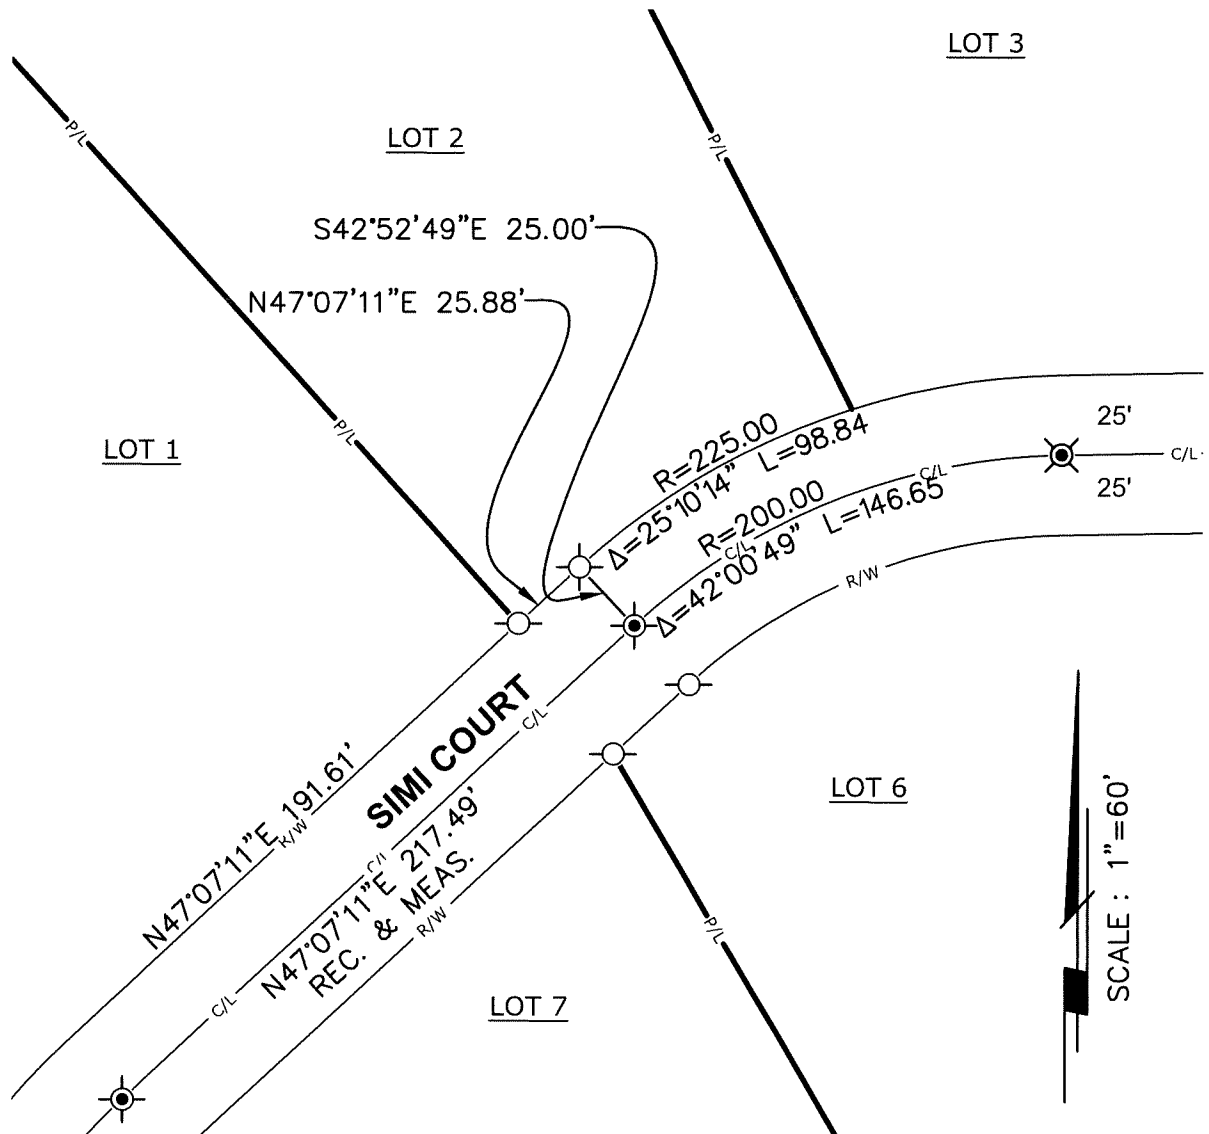

**LEGEND:**


- ⊗ FOUND 3/4" REBAR WITH CAP IN WELL LS 7736
- ⊗ FOUND 3/4" REBAR WITH CAP LS 7736
- ⊗ SET 1/2" x 24" REBAR WITH CAP LS 8474

REFERENCE:

40 M&P 83, SAN JOAQUIN COUNTY RECORDS

NOTE:

THIS CORNER RECORD IS BEING FILED TO FULFILL THE POST-CONSTRUCTION MONUMENT PRESERVATION REQUIREMENTS OF SECTION 8771 OF THE CALIFORNIA BUSINESS AND PROFESSIONS CODE. IT IS NOT THE RESULT OF A FULLY RESOLVED BOUNDARY SURVEY FOR ANY PARCEL OF REAL PROPERTY.

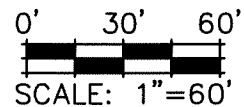

905 Sutter St., Suite 200, Folsom, CA 95630
 (916) 366-3040 Fax (916) 366-3303
 R. E. Y. ENGINEERS, Inc.
 Civil Engineers / Land Surveyors

CORNER RECORD EXHIBIT MAP

SCALE: 1"=60'
 JOB NO: 35573952
 DATE: 1-2-2025
 DWG: Simi Court