
	COF	NER REC		Document Number	CR-25-089				
City of		STOCKTON	County of _	SAN JOA	AQUIN , California				
Brief L	egal Descri	ption MULTIPLE LOT	S OF TRACT NO. 126	6, "CIMARRON UNIT NO	. 3", TRACT NO. 1547, "PALOMA				
	PARK ESTATES" AND TRACT NO. 2193, "COUNTRY GREENS UNIT NO. 3" OF SAN JOAQUIN COUNTY RECORDS  CORNER TYPE  COORDINATES (Optional)								
		OOMAL		N					
	10	☐ Government Corner	☐ Control	Elevation.					
	Ϊ́́́́	Meander	☑ Property	Units	U.S. Survey Foot				
-	+	Rancho	Other	Horizontal Datum					
	Ж			ZoneEpo	och Date				
		Date of Survey	02-05-2025	Vertical Datum					
0507	TON 40 TOM	MOUND A MODILL DANCE 6 F			Resources Code §§8801-8819				
SECI	ION 10, TOW	NSHIP 2 NORTH, RANGE 6 E	-AST, WI.D.B. & WI. [	Complies with Public	Resources Code §§8890-8902				
PLS Ac	t Ref.:	☐ 8765(d)	<b>⊠</b> 8771	<b>8773</b>	Other:				
Corner		∠ Left as found	☐ Established	Rebuilt	□ Pre-Construction				
Monum		☐ Found and tagged	Reestablished	Referenced	☐ Post-Construction				
See sheet #2 for description(s):  LOCATED EXISTING CENTERLINE MONUMENTS ALONG PROSPECTOR DRIVE, CHECOTAH CIRCLE, AND TAM O'SHANTER DRIVE PRIOR TO CONSTRUCTION OF PG&E FACILITIES  SURVEYOR'S STATEMENT  This Corner Record was prepared by me or under my direction in conformance with the Professional Land Surveyor's Act on 3 - 12 - 2025  Signed Amount P.L.S. or R.C.E. No. BCCC3									
This Corner Record was received March 13, 2025  and examined and filed March 18, 2025  Signed Ames E Hant P.L.S. or R.C.E. No. 8657  Title County Surveyor  County Surveyor Comment									

## STATEMENT OF PURPOSE:

THE PURPOSE OF THIS SURVEY IS TO IDENTIFY AND RECORD THE LOCATION OF EXISTING MONUMENTS PRIOR TO THE CONSTRUCTION OF PG&E FACILITIES AROUND THE MONUMENTS. THE PURPOSE OF THIS SURVEY IS NOT TO MAKE PROPERTY LINE DETERMINATIONS. LOT LINES SHOWN HEREON ARE FOR GENERAL LOCATION AND INFORMATIONAL PURPOSES ONLY.

## DATUM STATEMENT:

COORDINATES SHOWN HEREON ARE GRID AND ARE BASED ON CITY OF STOCKTON MONUMENTS 4N-8 AND 2N-1, CALIFORNIA COORDINATE SYSTEM (CCS83), ZONE III, 1983 NAD, AND SHOWN ON RECORD OF SURVEYS BOOK 33 OF SURVEYS, PAGE 20. THE PROJECT SPECIFIC SCALE FACTOR IS 0.9999451900031.

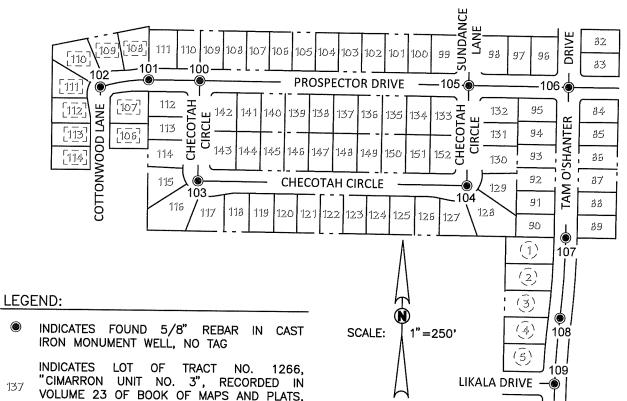

VOLUME 25 OF BOOK OF MAPS AND PLATS, PAGE 61, OF SAN JOAQUIN COUNTY RECORDS.

INDICATES LOT OF TRACT NO. 2193, "COUNTRY GREENS UNIT NO. 3", RECORDED IN VOLUME 29 OF BOOK OF MAPS AND PLATS, PAGE 12, OF SAN JOAQUIN COUNTY RECORDS.

PAGE 13, OF SAN JOAQUIN COUNTY

INDICATES LOT OF TRACT NO. 1547, "PALOMA PARK ESTATES", RECORDED IN

<b>A</b> I	$\sim$	_	_	
N	IΙΝ		-	٠

FIELD EFFORT INCLUDED A SEARCH FOR EXISTING CUT CROSSES AND CENTERLINE MONUMENTS AT THEIR TYPICAL LOCATION, ONLY THOSE FOUND ARE SHOWN.

GRID C	GRID COORDINATES (U.S. SURVEY FEET)					
Point	Northing	Easting				
100	2199284.7371'	6330148.0515'				
101	2199285.7427'	6330015.0404'				
102	2199265.7490'	6329889.7153'				
103	2199024.7593'	6330146.1030'				
104	2199019.2745'	6330846.3305'				
105	2199277.3931'	6331108.3670'				
106	2199279.3622'	6330848.3232'				
107	2198887.2683'	6331105.3775'				
108	2198678.5393'	6331092.8943'				
109	2198508.1224'	6331080.4545'				

RECORDS.