
CORNER RECORD

CR-25-091 Agency Index Document Number County of San Joaquin , California City of Stockton Brief Legal Description Monuments found along Carly Dr. per 40-M&P-11, S.J.C.R. COORDINATES (Optional) **CORNER TYPE** E. ☐ Government Corner Control Elevation ☐ U.S. Survey Foot ☐ Metric Meander Property Units SÉC ☐ Other Rancho Horizontal Datum **Epoch Date** Vertical Datum Date of Survey February 10th, 2025 ☐ Complies with Public Resourses Code §§8801-8819 C.M. Weber Grant Complies with Public Resourses Code §§8890-8902 Other: ⊠ 8771 8773 PLS Act Ref.: ■ 8765(d) □ Pre-Construction Rebuilt □ Left as found Established Corner/ Monument: Reestablished □ Referenced ☐ Post-Construction ☐ Found and tagged Narrative of corner identified and monument as found, set, reset, replaced, or removed: See sheet #2 for description(s): SURVEYOR'S STATEMENT This Corner Record was prepared by me or under my direction in conformance with the Professional Land Surveyors' Act on Signed P.L.S. or R.C.E. No. No. 8366 COUNTY SURVEYOR'S STATEMENT This Corner Record was received and examined and filed Signed Title County Surveyor's Comment

Page 1 of 2 BPELSG-2016

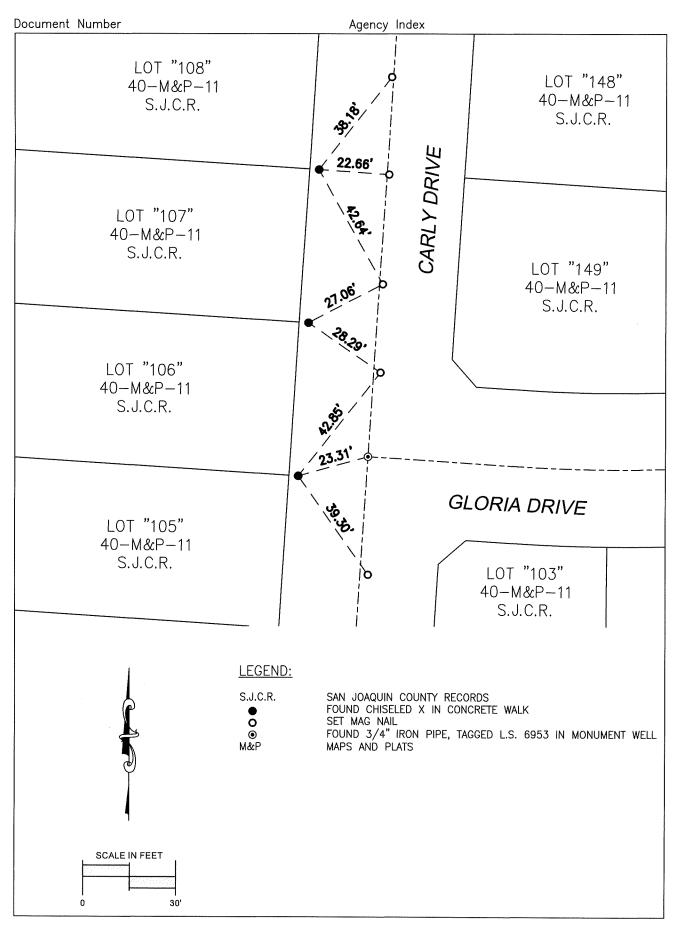

Page 2 of 2