CORNER RECORD


CR-25-099 Agency Index Document Number City of UNINC ORPORATED County of SAN JOAQUIN Brief Legal Description FOUND MAG NAIL AND BRASS WASHER, IN ASPHALT, TAG ILLEGIBLE, 2012'± NORTHEASTERLY OF CHERRYLAND AVENUE, PER CR 12-194, SAN JOAQUIN COUNTY SURVEYOR'S RECORDS **COORDINATES (Optional) CORNER TYPE** N. E. Control Elevation Government Corner U.S. Survey Foot **Property** Units Metric Meander Other Rancho Horizontal Datum Epoch Date Zone Vertical Datum Date of Survey DECEMBER 9, 2024 Complies with Public Resources Code §§8801-8819 Complies with Public Resources Code §§8890-8902 8771 8773 Other: PLS Act Ref.: 8765(d) Pre-Construction Established Rebuilt Left as found Corner/ Monument: Post-Construction Reestablished Referenced Found and tagged Narrative of corner identified and monument as found, set, reset, replaced, or removed: See sheet #2 for description(s): FOUND MAG NAIL AND BRASS WASHER, IN ASPHALT, TAG ILLEGIBLE, 2012'± NORTHEASTERLY OF CHERRYLAND AVENUE, PER CR 12-194, SAN JOAQUIN COUNTY SURVEYOR'S RECORDS THIS MONUMENT HAS BEEN REFERENCED PRIOR TO CONSTRUCTION. THE TIES SHOWN HEREON ARE FOR THE PURPOSE OF PERPETUATING FOUND MONUMENTS AND NO CLAIM IS MADE TO THEIR RELATIONSHIP TO THE BOUNDARY LOCATION SHOWN HEREON. SURVEYOR'S STATEMENT This Corner Record was prepared by me or under my direction in conformance with BRANDON BENTON the Professional Land Surveyors' Act on/ DECEMBER 17, 2024 P.L.S. or R.C.E. No. ____ 8679 Signed No. 8679 **COUNTY SURVEYOR'S STATEMENT** and filed March 21, 2025

Amas & Hart P.L.S. or R.C.E. No. 8657 This Corner Record was received and examined and filed LICENSE No. 8657 Signed SAN JOAQUIN COUNTY SURVEYOR Title

County Surveyor's Comment

MARK THOMAS 23-00033-179

LEGEND

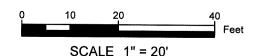

- APPROXIMATE LOT LINE

MONUMENT TIE LINE

FOUND MAG NAIL AND BRASS WASHER, IN ASPHALT, TAG ILLEGIBLE,


PER CR 12-194, SAN JOAQUIN COUNTY SURVEYOR'S RECORDS

O SET SURVEY SPIKE AND 1" ALUMINUM WASHER, "REF PT PLS 8679"

APN ASSESSOR'S PARCEL NUMBER

CR CORNER RECORD, SAN JOAQUIN COUNTY SURVEYOR'S RECORDS

RS RECORD OF SURVEY, SAN JOAQUIN COUNTY RECORDS

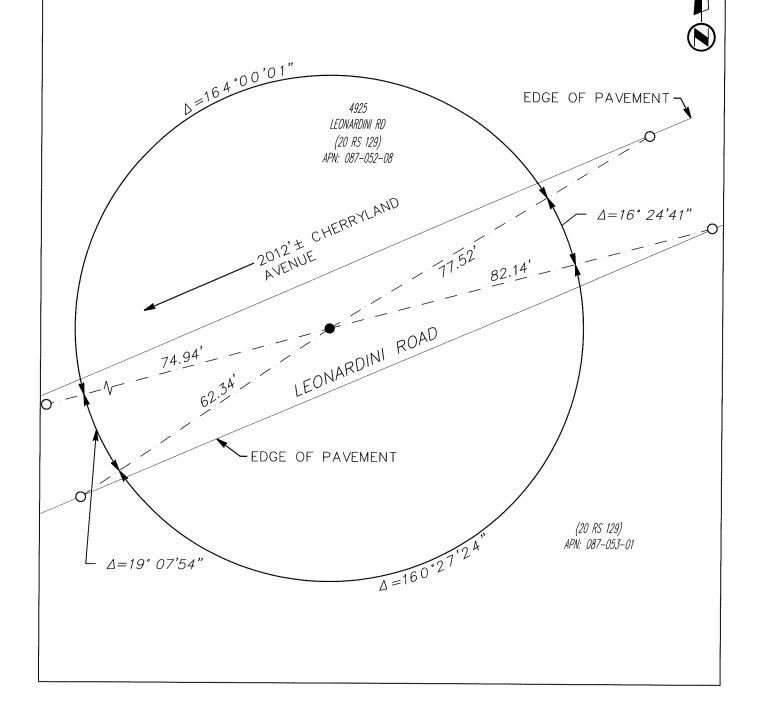

Page 2 of 2

BPELSG-2016