#### CR-25-104 CORNER RECORD Agency Index **Document Number** City of STOCKTON SAN JOAQUIN County of \_ California A PORTION OF BLOCK 83, "EAST OF CENTER STREET", Brief Legal Description SECTION 20 OF THE C.M. WEBER GRANT, CITY OF STOCKTON, S.J.C.R. **CORNER TYPE COORDINATES (Optional)** N. \_ ☐ Government Corner ☐ Control Elevation. □ Property Units ☑ U.S. Survey Foot ☐ Meander Rancho ☐ Other Horizontal Datum Zone Epoch Date Date of Survey 02-26-2025 Vertical Datum Complies with Public Resources Code §§8801-8819 Complies with Public Resources Code §§8890-8902 8765(d) **8771** 8773 Other: PLS Act Ref.: Left as found ☐ Established ☐ Rebuilt □ Pre-Construction Corner/ Monument: ☐ Found and tagged Reestablished Referenced ☐ Post-Construction Narrative of corner identified and monument as found, set, reset, replaced, or removed: See sheet #2 for description(s):

### SURVEYOR'S STATEMENT

This Corner Record was prepared by me or under my direction in conformance with

the Professional Land Surveyor's Act on 3 - 24 - 2025

Signed P.L.S. or R.C.E. No. 8663



This Corner Record was received April 1, 2025

and examined and filed April 11, 2025

Signed F.L.S. or R.C.E. No. 8657

Title County Surveyor

**County Surveyor's Comment** 



## DATUM STATEMENT:

COORDINATES SHOWN HEREON ARE GRID AND ARE BASED ON CITY OF STOCKTON MONUMENTS 1S-9 AND 1S-10, CALIFORNIA COORDINATE SYSTEM (CCS83), ZONE III, 1983 NAD, AND SHOWN ON RECORD OF SURVEYS BOOK 33 OF SURVEYS, PAGE 20. THE PROJECT SPECIFIC SCALE FACTOR IS 0.9999399855557.

# LEGEND:

- X INDICATES FOUND CHISELED "X" FLUSH IN CONCRETE
- INDICATES FOUND 1" BRASS DISC, TAGGED "LS 8501"
- (83) INDICATES BLOCK OF "EAST OF CENTER STREET" MAP, AND BEING A PORTION OF SECTION 20, C.M. WEBER GRANT., OF SAN JOAQUIN COUNTY RECORDS.
- RS RECORD OF SURVEY, S.J.C.R.
- S.J.C.R. SAN JOAQUIN COUNTY RECORDS


## STATEMENT OF PURPOSE:

THE PURPOSE OF THIS SURVEY IS TO IDENTIFY AND RECORD THE LOCATION OF EXISTING MONUMENTS PRIOR TO THE CONSTRUCTION OF PG&E FACILITIES AROUND THE MONUMENTS. THE PURPOSE OF THIS SURVEY IS NOT TO MAKE PROPERTY LINE DETERMINATIONS. LOT LINES SHOWN HEREON ARE FOR GENERAL LOCATION AND INFORMATIONAL PURPOSES ONLY.

## NOTE:

FIELD EFFORT INCLUDED A SEARCH FOR EXISTING CUT CROSSES AND BRASS DISCS AND MAG NAILS AT THEIR TYPICAL LOCATION, ONLY THOSE FOUND WITHIN PG&E CONSTRUCTION AREA ARE SHOWN.

GRID COORDINATES (U.S. SURVEY FEET)		
Point	Northing	Easting
100	2172183.7414'	6335662.3705'
101	2172065.8949'	6335908.6480'
102	2172066.1362'	6335907.8707'

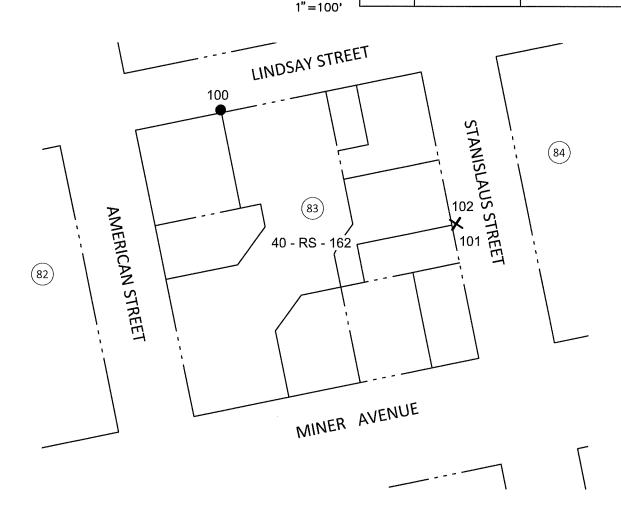

SCALE: