
Agency Index CR-25-158 CORNER RECORD Document Number San Joaquin , California City of County of PARCEL 3, R.S. 16-15, S.J.C.R. Brief Legal Description **CORNER TYPE COORDINATES (Optional)** E. Government Corner Elevation Control U.S. Survey Foot Property Units Meander Metric Rancho Other Horizontal Datum Zone __Epoch Date ____ Date of Survey April 10, 2025 Vertical Datum Complies with Public Resources Code §§8801-8819 SECTION 91, C.M. WEBER GRANT Complies with Public Resources Code §§8890-8902 8765(d) 8771 PLS Act Ref.: 8773 Other: Left as found Established Rebuilt Pre-Construction Corner/ Monument: Found and tagged Reestablished Referenced Post-Construction Narrative of corner identified and monument as found, set, reset, replaced, or removed: See sheet #2 for description(s): SURVEYOR'S STATEMENT This Corner Record was prepared by me or under my direction in conformance with the Professional Land Surveyors' Act on 7269 Signed **COUNTY SURVEYOR'S STATEMENT** This Corner Record was received and examined and filed Signed

County Surveyor's Comment

No. 8657

Title

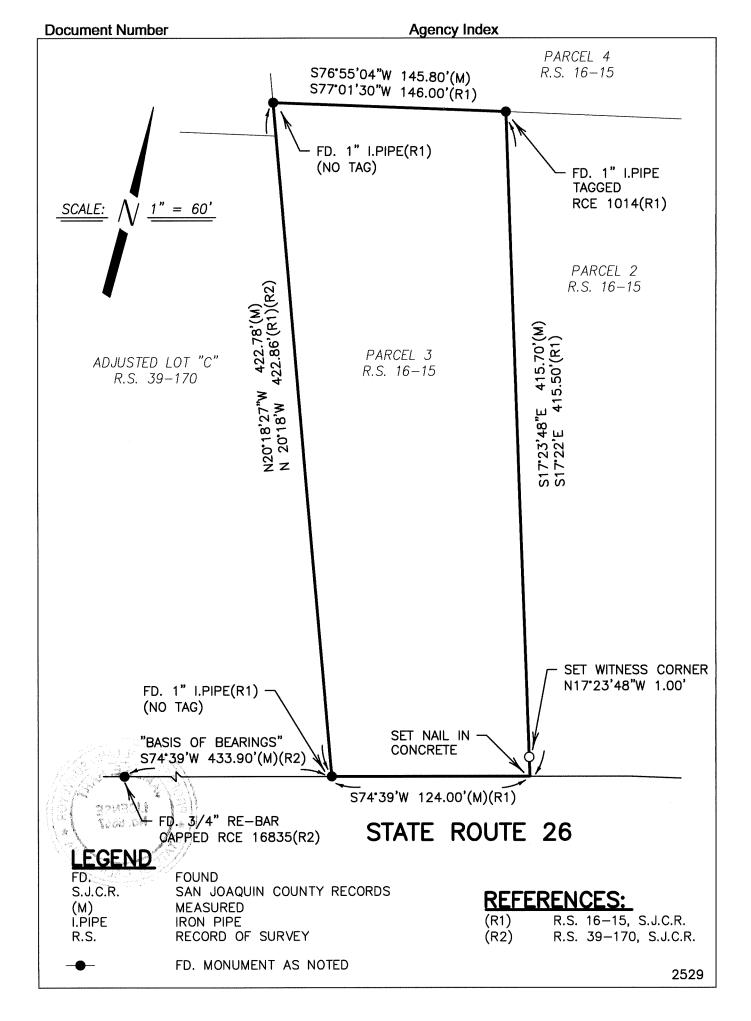

BPELSG-2016 Page 2 of 2