CORNER RECORD Agency Index Document Number RIPON SAN JOAQUIN County of City of Brief Legal Description POST CONST. SURVEY TO ESTABLISH SSJID SURVEY BENCHMARK ELEV. **COORDINATES (Optional) CORNER TYPE** Government Corner Elevation Control U.S. Survey Foot Metric Meander Property Units Rancho Other Horizontal Datum Zone **Epoch Date** NAVD 1988 March 24, 2025 Date of Survey Vertical Datum Complies with Public Resources Code §§8801-8819 Complies with Public Resources Code §§8890-8902 8771 8773 Other: PLS Act Ref.: 8765(d) Left as found Established Rebuilt **Pre-Construction** Corner/ **Monument:** Post-Construction Found and tagged Reestablished Referenced Narrative of corner identified and monument as found, set, reset, replaced, or removed: See sheet #2 for description(s): THIS IS A POST CONSTRUCTION SURVEY TO ESTABLISH THE ELEVATION OF A SSJID SURVEY BENCHMARK ON TOP OF AN IRRIGATION STRUCTURE. A CLOSED LEVEL CIRCUIT WAS RUN FROM THE CITY OF RIPON G.P.S. SURVEY CONTROL NETWORK POINT NO. 6061 TO ALL **ELEVATIONS SHOWN.** SURVEYOR'S STATEMENT This Corner Record was prepared by me or under my direction in conformance with the Professional Land Surveyors' Act on March 25, 2025 P.L.S. or R.C.E. No. <u>5650</u> Signed

COUNTY SURVEYOR'S STATEMENT

This Corner Record was received May 15, 2025

and examined and filed May 16, 2025


Signed P.L.S. er R.C.E. No. 8657

Title County Surveyor

LICENSE No. 8657

County Surveyor's Comment

BPELSG-2016 Page 1 of 2

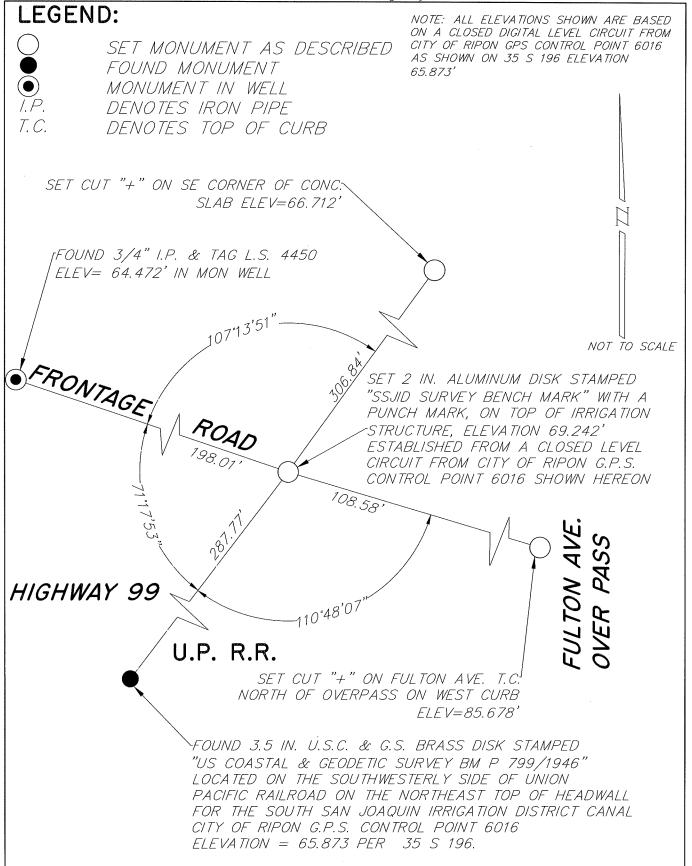

BPELSG-2016 Page 2 of 2