COR	NER RE	CORD	Agency li Document		OR-25-1	62
City of	STOCKTON				JOAQUIN	, California
Brief Legal M. D. B. & N	Description A PO M., AND AS SHOWN O YS AT PAGE 228, IN	N THESE CERTAIN M	THWEST QUARTE	R OF SECT	TON 16, T. 2 VEYS AT PAGE	N., R. 6 E., 43, IN BOOK
	7	CORNER T	YPE N.	C	COORDINATE E.	S (Optional)
	Meande Rancho	<u> </u>	er Electric	evation its	Metric U mEpoch Date ublic Resources C	S. Survey Foot X
PLS Act Ref:	□ 8765(d)	X 8771	□ 8773	nplies with Pu	ublic Resources C	code §§8890-8902
Corner/ Monument:	X Left as found		Rebuilt Referen	ced	X Pre-0	Construction Construction
See sheet BE THE SOUTH APPEARS TO B OF PACIFIC AVE. WITH WASHER SOUTHERLY SO	orner identified and mo #2 for description (s): HWEST CORNER OF PAI E THE SOUTHEAST CORNEF THAT APPEARS TO BE TH STAMPED PLS 8660 COUTHWEST CORNER ANI HAT APPEARS TO BE T 41-S-14.	FD. 1/2" REBAR, NO RCEL 1, AND ALSO FD. ROF PARCEL 3, SHOWN E SOUTHEAST CORNER OF THE EASTERLY SID ALSO FD. IRON PIP	TAG, ON THE N 3/4" REBAR, NO 1 ON SAID 15-S THE PARCEL ENTI E OF THORNTON E WITH PLASTIC	IORTH SIDE TAG, ON THE -43. FD. 3/ ITLED "KELLY" RD. THAT A CAP STAMP	OF RIVARA RD. NORTH SIDE OF 4" REBAR, NO TAG PER 11—S—228 APPEARS TO BE ED PLS 8660,	F RIVARA RD. THAT , ON THE WEST SIDE B. FD. MAG NAIL THE MOST
	SURVEYO	R'S STATEMENT				FORTES S
	al Land Surveyors' Act	5, P.L.S.	/7/2025			6148 OF CALLEGRAPH
	COUNTY SUR	EYOR'S STATEM	MENT			
This Corner R	ecord was received	May 16, 2	2025		(5)0	ES E. A.S.
and examined Signed Title	ecord was received and filed Junganes & Had County Survey	e 2, 2025 P.L.S.	or R.C.E. No.	657	**************************************	LICENSE No. 8657
County Survey	vor's Comment					PFCALIFORM

STATEMENT OF PURPOSE:


THE PURPOSE OF THIS SURVEY IS TO IDENTIFY AND RECORD THE LOCATION OF EXISTING MONUMENTS PRIOR TO THE CONSTRUCTION OF PG&E FACILITIES AROUND THE MONUMENTS. THIS SURVEY DOES NOT ATTEMPT TO MAKE ANY PROPERTY LINE DETERMINATIONS. LOT LINES SHOWN HEREON ARE FOR GENERAL LOCATION AND INFORMATIONAL PURPOSES ONLY.

DATUM STATEMENT:


COORDINATES SHOWN HEREON ARE GRID AND ARE BASED ON CITY OF STOCKTON MONUMENT 10, CALIFORNIA COORDINATE SYSTEM(CCS83). ZONE III, 1983 NAD, AND SHOWN ON RECORD OF SURVEY BOOK 35 OF SURVEYS, PAGE 5. THE PROJECT SPECIFIC COMBINED SCALE FACTOR IS 0.99994433.

LEGEND

BPELSG-2016

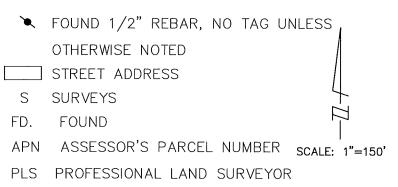

POINT#	NORTHING	EASTING		
16307	2194359.897	6324397.006		
16308	2194640.750	6323640.370		
16309	2194727.705	6324135.287		
16310	2194990.721	6324224.855		
16311	2195011.482	6324210.409		

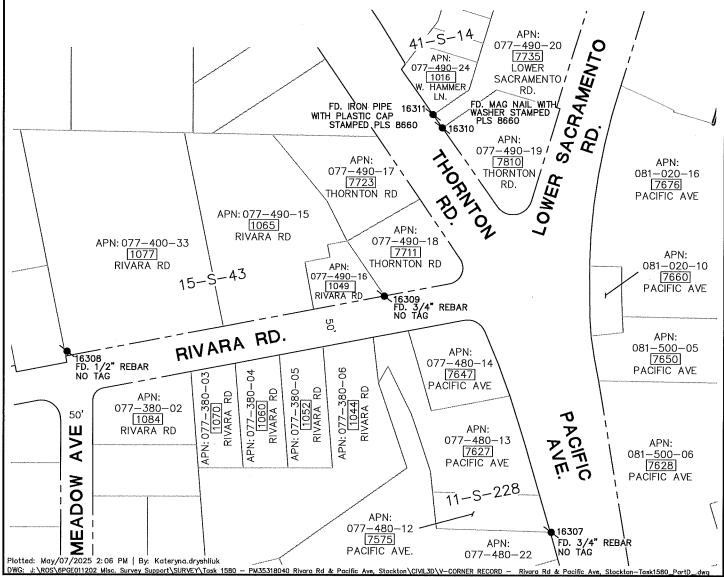

Page 2 of 2