CR-25-164 Agency Index CORNER RECORD **Document Number** County of SAN JOAQUIN , California City of **RIPON** Brief Legal Description Found iron pipe tagged L.S. 6953 as shown on Lot 106 of that certain map entitled "TRACT NO. 3387 CHESAPEAKE III" filed in Book 38 of MAPS & PLATS at Page 89, San Joaquin County Records. **CORNER TYPE COORDINATES (Optional)** Elevation Government Corner Control U.S. Survey Foot 🛛 Metric Units Meander Property Horizontal Datum _____ Other Rancho Zone Epoch Date ____ Vertical Datum Date of Survey 8/22/2023 Complies with Public Resources Code §§8801-8819 Complies with Public Resources Code §§8890-8902 SECTION 19, T.2S., R.8E. M.D.B.&M. X 8771 8773 Other: PLS Act Ref: ☐ 8765(d) X Pre-Construction ☐ Established Rebuilt Corner/ X Left as found Monument: ☐ Found and tagged ☐ Reestablished X Referenced Post-Construction Narrative of corner identified and monument as found, set, reset, replaced, or removed: X See sheet #2 for description (s): REFERENCED ONE IRON PIPE FOUND PER 38 MP 89. MONUMENT REFERENCED PER PLS ACT 8771 SECTION "B". ANDSUR SURVEYOR'S STATEMENT This Corner Record was prepared by me or under my direction in conformance with L. E. CARTER JR Exp. 3/31/2026 5/14/2025 the Professional Land Surveyors' Act on No. 6148 _ P.L.S. No. _____ Signed. ESTER E. CARTER JR. COUNTY SURVEYOR'S STATEMENT This Corner Record was received. and examined and filed_ LICENSE No. 8657 Signed_ Title_ County Surveyor's Comment ____


Agency Index

STATEMENT OF PURPOSE:

THE PURPOSE OF THIS SURVEY IS TO IDENTIFY AND RECORD THE LOCATION OF EXISTING MONUMENTS PRIOR TO THE CONSTRUCTION OF PG&E FACILITIES AROUND THE MONUMENTS. THIS SURVEY DOES NOT ATTEMPT TO MAKE ANY PROPERTY LINE DETERMINATIONS. LOT LINES SHOWN HEREON ARE FOR GENERAL LOCATION AND INFORMATIONAL PURPOSES ONLY.

DATUM STATEMENT:


COORDINATES SHOWN HEREON ARE GRID AND ARE BASED ON CITY OF RIPON MONUMENTS 6016 AND 6019, CALIFORNIA COORDINATE SYSTEM(CCS83). ZONE III, 1983 NAD, AND SHOWN ON RECORD OF SURVEY BOOK 35 OF SURVEYS, PAGE 196. THE PROJECT SPECIFIC COMBINED SCALE FACTOR IS 0.99992577.

LEGEND

 \mathbf{x} FOUND IRON PIPE TAGGED LS 6953 PER 38-MP-89

STREET ADDRESS

MP MAPS AND PLATS

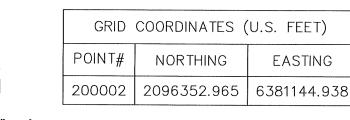

SCALE: 1"=60'

SHASTA AVENUE

LOT 105 108 SHASTA AVENUE

NORTH RIPON ROAD

NORTH RIPON **ROAD**

Plotted: May/14/2025 11:38 AM | By: Lester.carter

LOT 107 1265 NORTH RIPON ROAD

DWG: J:\ROS\6PGE011202 Misc. Survey Support\SURVEY\Task 1328 - PM35457729 1265 N Ripon Rd, Ripon\CIVIL3D\V-CORNER RECORD - N Ripon Rd - Task 1328_RR.dwg

LOT 106

1271

NORTH RIPON **ROAD**

BPELSG-2016

Page 2 of 2

X 200002

22828