
CORNER	RECO	RD	Agency		-	CR-2	25-165	5
City of STO	CKTON					JOAQUIN		California
Brief Legal Description		13, BLK. 2, MA						
JOAQUIN COUNTY RECORD COUNTY SURVEYOR'S REC		N ON MAP OF	SURVEY	FILED	AS CHW	AA-342,	SAN JOAC	QUIN
	ONDS.							
		CORNER TY	PE	N.	C	COORDINA	ATES (O	ptional)
	Government Corr	er Contro		Elevati	on			1771
	Meander	Proper	ty					rvey Foot 🛚
	Rancho	Other						
	Date of Survey	0/0/2024				Lpoch b		
	Date of Survey	<u> </u>				ıblic Resourd ıblic Resourd	-	-
PLS Act Ref: 8765(d) 🗓 87	71	8773	3			Other:	
Corner/ X Left as Monument: Found a	-	tablished established	☐ Rebu		ž		Pre-Constr Post-Const	
X See sheet #2 for described WILSON WAY THAT AP OF LOT 13 AS SHOW SURVEY CHW AA−342	PEARS TO BE N ON SAID 5-	ON THE WES MP-17, SAN	TERLY F JOAQUI	PROLO N CO	NGATIO UNTY F	N OF TH	E SOUTH	H LINE
S	URVEYOR'S SI	ATEMENT					RAAS	Ep. T
This Corner Record was prepared by me or under my direction in conformance with								
the Professional Land Surveyors' Act on 5/7/2025								
Signed Tulu Z	* 1	P.L.S. No		6148	.	No.	614 ATE OF CA	8 P
COUNT	TY SURVEYOR	S STATEME	NT			_	VALLA	
This Corner Record was re-		/			40	//5	SINES E.	
and examined and filed June 2, 2025 Signed Jaws E Had P.L.S. er R.C.E. No. 8657 Title County Surveyor								
Signed James El	Fad	P.L.S. or F	R.G.E. No.	86	<u>57</u>	(*)	No. 865	
Title County -	Surveyor					C. T.	E OF CALL	FORM
County Surveyor's Comme	nt			-				
			-					

STATEMENT OF PURPOSE:

THE PURPOSE OF THIS SURVEY IS TO IDENTIFY AND RECORD THE LOCATION OF EXISTING MONUMENTS PRIOR TO THE CONSTRUCTION OF PG&E FACILITIES AROUND THE MONUMENTS. THIS SURVEY DOES NOT ATTEMPT TO MAKE ANY PROPERTY LINE DETERMINATIONS. LOT LINES SHOWN HEREON ARE FOR GENERAL LOCATION AND INFORMATIONAL PURPOSES ONLY.

DATUM STATEMENT:

COORDINATES SHOWN HEREON ARE GRID AND ARE BASED ON CITY OF STOCKTON MONUMENT 426, CALIFORNIA COORDINATE SYSTEM(CCS83). ZONE III, 1983 NAD, AND SHOWN ON RECORD OF SURVEY BOOK 35 OF SURVEYS, PAGE 5. THE PROJECT SPECIFIC COMBINED SCALE FACTOR IS 0.99994017.

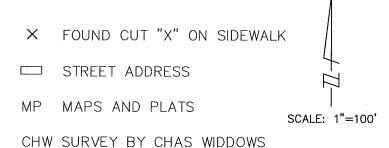

GRID	COORDINATES (U.S. FEET)				
POINT#	NORTHING	EASTING			
200001	2172303.308	6339069.258			

