
CORNER RECORD

CR-25-170 Agency Index **Document Number** City of UNINCORPORATED County of SAN JOAQUIN , California PARCEL 1, 19 P.M. 145 & PARCEL A, 13 P.M. 44, S.J.C. RECORDS Brief Legal Description **COORDINATES (Optional) CORNER TYPE** E. Government Corner Control Elevation X U.S. Survey Foot Meander Property Units Metric Rancho Other Horizontal Datum Zone Epoch Date Date of Survey April 11, 2025 Vertical Datum Complies with Public Resources Code §§8801-8819 T 4N., R 7E. Complies with Public Resources Code §§8890-8902 **X** 8771 PLS Act Ref.: 8765(d) 8773 Other: Left as found Established Rebuilt **Pre-Construction** Corner/ Monument: Referenced Post-Construction Found and tagged Reestablished Narrative of corner identified and monument as found, set, reset, replaced, or removed: ✓ See sheet #2 for description(s): FOUND 1" I.P. W/ PLUG STAMPED PLS 4124 AT THE SOUTHEAST CORNER OF PARCEL 1, 19 P.M. 145, S.J.C. RECORDS. FOUND RAILROAD SPIKE IN MON. WELL AT THE EAST QUARTER CORNER OF SEC. 30, T4N., R7E. PER 19 P.M. 145, S.J.C. RECORDS. SURVEYOR'S STATEMENT This Corner Record was prepared by me or under my direction in conformance with the Professional Land Surveyors' Act on April 15, 2025 P.L.S.)or R.C.E. No. No. 8474 Signed **COUNTY SURVEYOR'S STATEMENT** This Corner Record was received and examined and filed P.L.S. OFR.C.E. No. 8657 Signed Title

County Surveyor's Comment



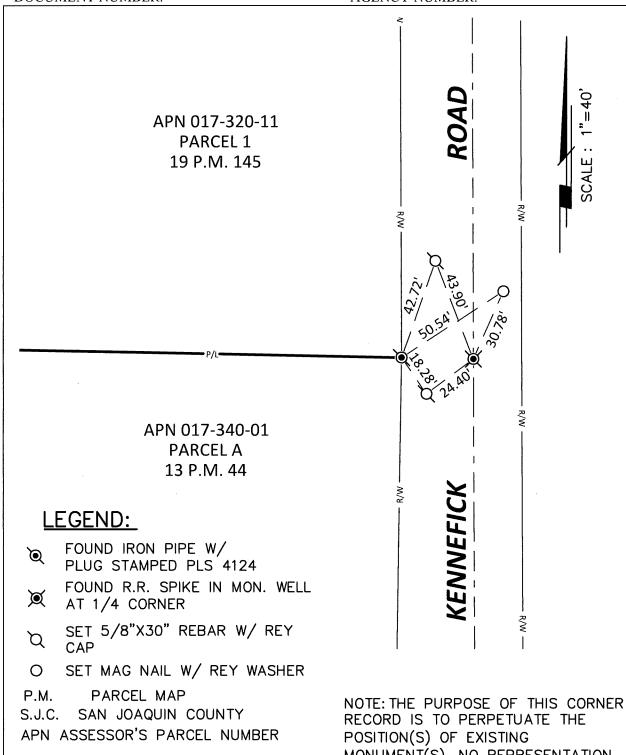

REFERENCES:

19 P.M. 145, S.J.C. RECORDS

13 P.M. 44, S.J.C. RECORDS

NOTE: THE PURPOSE OF THIS CORNER RECORD IS TO PERPETUATE THE POSITION(S) OF EXISTING MONUMENT(S). NO REPRESENTATION IS MADE TO ANY RELATIVE POSITION(S) OF SAID MONUMENT(S). ALL RIGHT OF WAY, PROPERTY LINES, CENTERLINES AND OTHERS ARE FOR GRAPHICAL REPRESENTATION ONLY.

905 Sutter St., Suite 200, Folsom, CA 95630 (916) 366-3040 Fax (916) 366-3303 R. E. Y. ENGINEERS, Inc. Civil Engineers / Land Surveyors

A 95630 03 **(**

CORNER RECORD EXHIBIT MAP

SCALE:	1"=40'
JOB NO: 47	7120258
DATE: 4/1:	
DWG: N. KENN	
