
## CORNER RECORD

Agency Index **Document Number** County of SAN JOAQUIN California Brief Legal Description FOUND MONUMENT ALONG THE SOUTHERLY RIGHT-OF-WAY LINE OF ELLIOTT ROAD. **COORDINATES (Optional) CORNER TYPE** E. N. Elevation Government Corner Control X U.S. Survey Foot X Property Metric Units Meander SEC Other Rancho Horizontal Datum **Epoch Date** Zone Date of Survey September 14, 2023 Vertical Datum Complies with Public Resources Code §§8801-8819 T4N/R7E Complies with Public Resources Code §§8890-8902 8773 Other: X 8771 PLS Act Ref.: 8765(d) **Pre-Construction** Left as found Established Rebuilt Corner/ Monument: Reestablished Referenced Post-Construction Found and tagged Narrative of corner identified and monument as found, set, reset, replaced, or removed: See sheet #2 for description(s): THE FOUND MONUMENT(S) SHOWN ON THIS CORNER RECORD WERE FOUND IN THE APPROXIMATE RECORD LOCATION OF THE CORNER(S) ON PM 10-03, SAN JOAQUIN COUNTY RECORDS. I DID NOT VERIFY THE IDENTITY OR VALIDITY OF THE MONUMENT FOUND AS ACTUALLY MARKING THE PROPERTY CORNER. SURVEYOR'S STATEMENT This Corner Record was prepared by me or under my direction in conformance with No. 8489 the Professional Land Surveyors' Act on September 18, 2023 8489 P.L.S. or R.C.E. No. Signed OF CALL **COUNTY SURVEYOR'S STATEMENT** This Corner Record was received June 3, 2025.
Haut P.L.S. OFR.C.E. No. 8657 and examined and filed LICENSE Signed No. 8657 Title

Page 1 of 2

County Surveyor's Comment

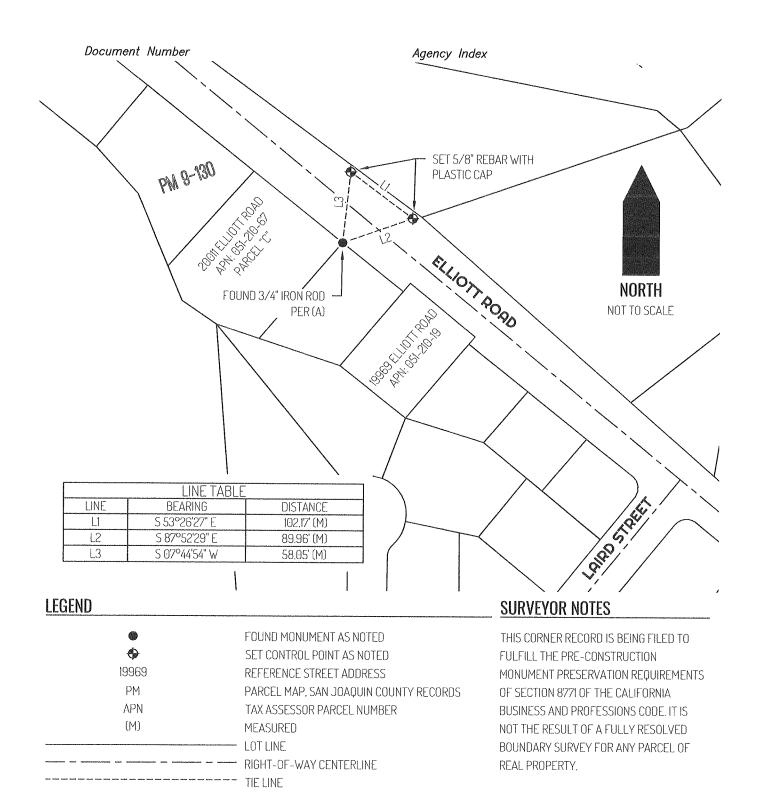

## REFERENCE

(A) PARCEL MAP BOOK 10, AT PAGE 3, SAN JOAQUIN COUNTY RECORDS