
CORNER RECORD

Document Number California SAN JOAQUIN County of City of Brief Legal Description FOUND MONUMENTS ALONG SOUTHERN BOUNDARY OF APN 051-210-27. **COORDINATES (Optional) CORNER TYPE** E. N. Elevation Government Corner Control X U.S. Survey Foot X Property Units Metric Meander SEC Other Horizontal Datum Rancho **Epoch Date** Zone Date of Survey September 14, 2023 Vertical Datum Complies with Public Resources Code §§8801-8819 T4N/R7E Complies with Public Resources Code §§8890-8902 8773 Other: X 8771 PLS Act Ref .: 8765(d) X Pre-Construction Rebuilt Established Left as found Corner/ Post-Construction Monument: Referenced Reestablished Found and tagged Narrative of corner identified and monument as found, set, reset, replaced, or removed: See sheet #2 for description(s): THE FOUND MONUMENT(S) SHOWN ON THIS CORNER RECORD WERE FOUND IN THE APPROXIMATE RECORD LOCATION OF THE CORNER(S) ON RS 25-23, SAN JOAQUIN COUNTY RECORDS. I DID NOT VERIFY THE IDENTITY OR VALIDITY OF THE MONUMENT FOUND AS ACTUALLY MARKING THE PROPERTY CORNER. SURVEYOR'S STATEMENT This Corner Record was prepared by me or under my direction in conformance with No. 8489 September 18, 2023 the Professional Land Surveyors' Act on 8489 P.L.S. or R.C.E. No. Signed OF CALL COUNTY SURVEYOR'S STATEMENT This Corner Record was received and examined and filed LICENSE Signed No. 8657 Title County Surveyor's Comment

CR-25-174

Agency Index

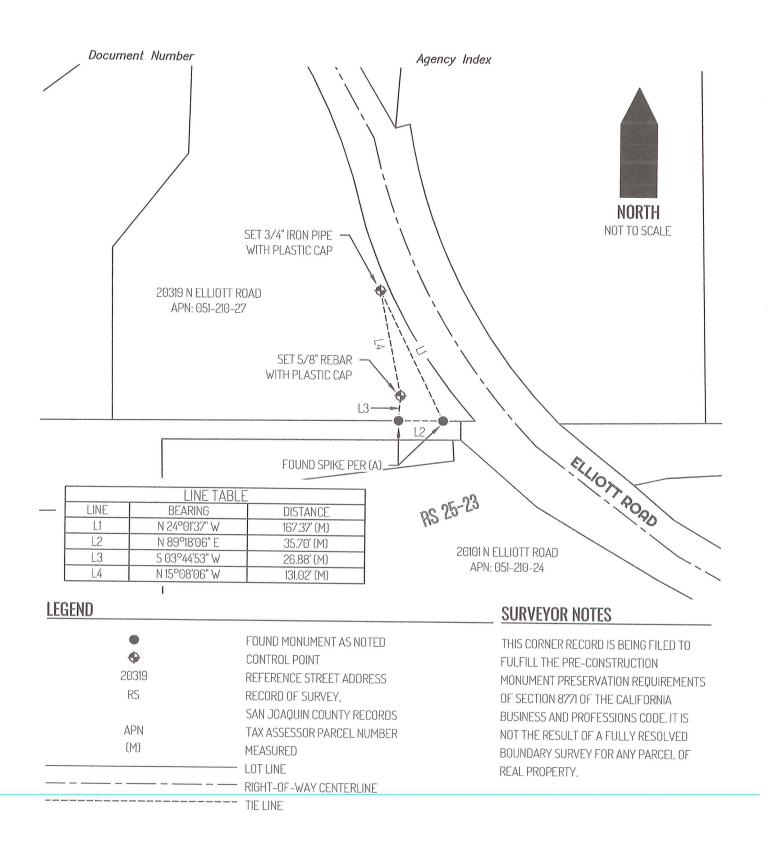

REFERENCE

(A) RECORD OF SURVEY BOOK 25, AT PAGE 23, SAN JOAQUIN COUNTY RECORDS