

CORNER RECORD


Agency Index

CR-25-178

Document Number

City of STOCKTON County of SAN JOAQUIN, California

Brief Legal Description FOUND MONUMENTS SHOWN ON CR-24-218, SAN JOAQUIN COUNTY SURVEYOR'S RECORDS.

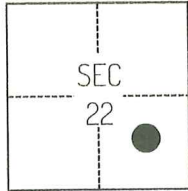CORNER TYPE**COORDINATES (Optional)**

C.M. WEBER GRANT

- ☐ Government Corner ☐ Control
☐ Meander ☒ Property
☐ Rancho ☐ Other

Date of Survey February 15, 2023

N. _____ E. _____

Elevation _____

Units

☐ Metric☒ U.S. Survey Foot

Horizontal Datum _____

Zone _____

Epoch Date _____

Vertical Datum _____

☐ Complies with Public Resources Code §§8801-8819☐ Complies with Public Resources Code §§8890-8902

PLS Act Ref.:

☐ 8765(d)☒ 8771☐ 8773☐ Other:Corner/
Monument:☒ Left as found☐ Established☐ Rebuilt☐ Pre-Construction☐ Found and tagged☒ Reestablished☒ Referenced☒ Post-Construction

Narrative of corner identified and monument as found, set, reset, replaced, or removed:

☒ See sheet #2 for description(s):**SURVEYOR'S STATEMENT**

This Corner Record was prepared by me or under my direction in conformance with

the Professional Land Surveyors' Act on October 1, 2024

Signed

P.L.S. or R.C.E. No.

8489

**COUNTY SURVEYOR'S STATEMENT**

This Corner Record was received

May 19, 2025

and examined and filed

June 3, 2025

Signed

P.L.S. or R.C.E. No.


8657

Title

County Surveyor

County Surveyor's Comment



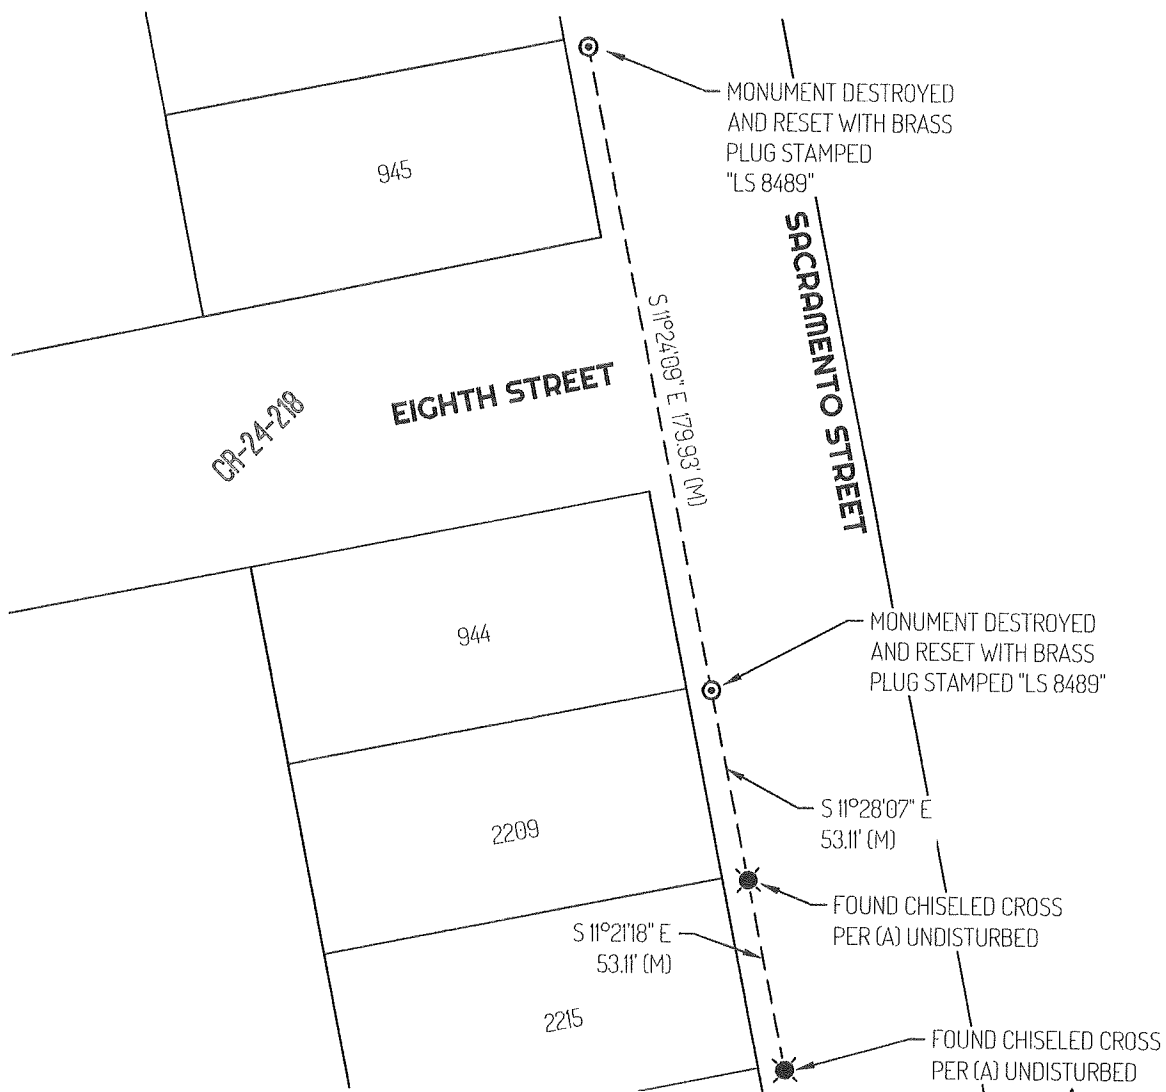

LEGEND

- ⊙ MONUMENT SET AS NOTED
- ⊙ FOUND CHISELED CROSS AS NOTED
- 2209 REFERENCE STREET ADDRESS
- CR CORNER RECORD, SAN JOAQUIN COUNTY SURVEYOR'S RECORDS
- (M) MEASURED
- TIE LINE
- LOT LINE

REFERENCE

- (A) CORNER RECORD 24-218, SAN JOAQUIN COUNTY SURVEYOR'S RECORDS

