CORNER RECORD

Agency Index

OR - 25 - 195

Document Number

City of	Stockton	County of _	San Joaqu	in, California
Brief Legal Description Lots 22, 23, 27, 28, and 29, M.&P. 23-10				
		NER TYPE	N Metric Units	3-10 ATES (Optional) E. U.S. Survey Foot h Date esources Code §§8801-8819 esources Code §§8890-8902 Other:
Management	Left as found Found and tagged	Established Reestablished	Rebuilt Referenced	Pre-Construction Post-Construction
Narrative of corner identified and monument as found, set, reset, replaced, or removed: See sheet #2 for description(s): Surveyor's Statement				
This Corner Record was record and examined and filed Signed Title County County County Surveyor's Contact Surveyor's Conta			8657	LICENSE No. 8657

LEGEND:

M.&P. MAPS AND PLATS, BOOK AND PAGE, SAN JOAQUIN COUNTY RECORDS

 FOUND CHISELED CROSS PER CORNER RECORD 24-495, SAN JOAQUIN COUNTY SURVEYOR'S RECORDS

DESCRIPTION:

THIS CORNER RECORD IS FOR THE PURPOSE OF MONUMENT PRESERVATION. REFERENCES WERE SET FOR FOUND MONUMENTS AS NOTED ON DIAGRAM. NO BOUNDARY ANALYSIS WAS PERFORMED. THIS CORNER RECORD DOES NOT VERIFY THE MONUMENT(S) TO BE IN THE CORRECT POSITION.



ANGLE AND DISTANCE TABLE

ANGLE

082°24'09"

051°25'43"

046°06'52"

BS DISTANCE FS DISTANCE


42.51' 167.34'

186.40'

133.64

71.95'

118.41'

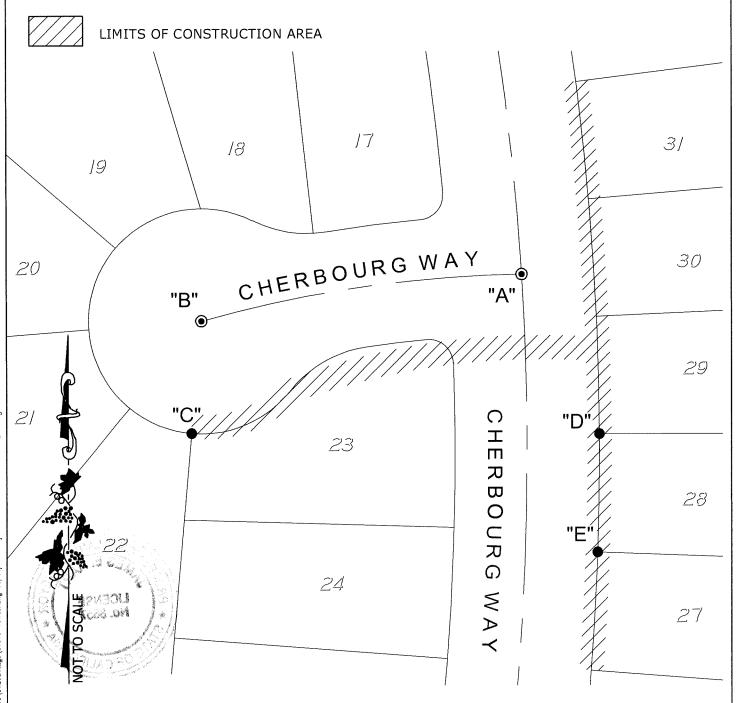

S.\Projects\2017\17046-79\3_Drawings\17046-79_CR.dwg 95/02/25 1:54pm-CARTER-XREFS: 17046-79_HC.dwg

BS-O-FS

A-C-B

A-D-B

A-E-B