## **CORNER RECORD**

Agency Index

CR-25-198

Document Number

San Joaquin

V 1/4 of Section 2 T 2 N R 9 F

City of	County of	San Joaqui	n, California
Brief Legal Description	A Portion of the N.V	V. 1/4 of Section 2, T.2	N., R.9 E.
CORNER TYPE		COORDINATES (Optional)  N E.	
Governme  Meander  Rancho	ent Corner Control  Property  Other	Elevation Units Metric Horizontal Datum	U.S. Survey Foot
Date of Surve	y May 6, 2025	Vertical Datum Complies with Public Re	esources Code §§8801-8819 esources Code §§8890-8902
PLS Act Ref.: 8765(d)	× 8771	8773	Other:
Corner/ Monument:  Left as found Found and tagged	Established Reestablished	Rebuilt Referenced	Pre-Construction Post-Construction
SURVEYOR	R'S STATEMENT		SONAL LAND SCA
This Corner Record was prepared by me or under my direction in conformance with  the Professional Land Surveyors' Act on May 6, 2025  Signed P.L.S. or R.C.E. No. PLS 7889			
COUNTY SURVI	EYOR'S STATEMENT		
This Corner Record was received  and examined and filed  Signed  Title  Title	P.L.S. <del>or R.C.E</del> . No.	8657	LICENSE No. 8657

**County Surveyor's Comment** 

## LEGEND:

R.S. RECORD OF SURVEY, BOOK AND PAGE, SAN JOAQUIN COUNTY RECORDS

SEC. SECTION

FD FOUND

 FOUND MONUMENT AS NOTED PER CORNER RECORD 24-380, SAN JOAQUIN COUNTY SURVEYOR'S RECORDS

ANGLE AND DISTANCE TABLE

ANGLE

117°47'53"


BS DISTANCE FS DISTANCE

50.00'

50.00'

## **DESCRIPTION:**

THIS CORNER RECORD IS FOR THE PURPOSE OF MONUMENT PRESERVATION. REFERENCES WERE SET FOR FOUND MONUMENTS AS NOTED ON DIAGRAM. NO BOUNDARY ANALYSIS WAS PERFORMED. THIS CORNER RECORD DOES NOT VERIFY THE MONUMENT(S) TO BE IN THE CORRECT POSITION.

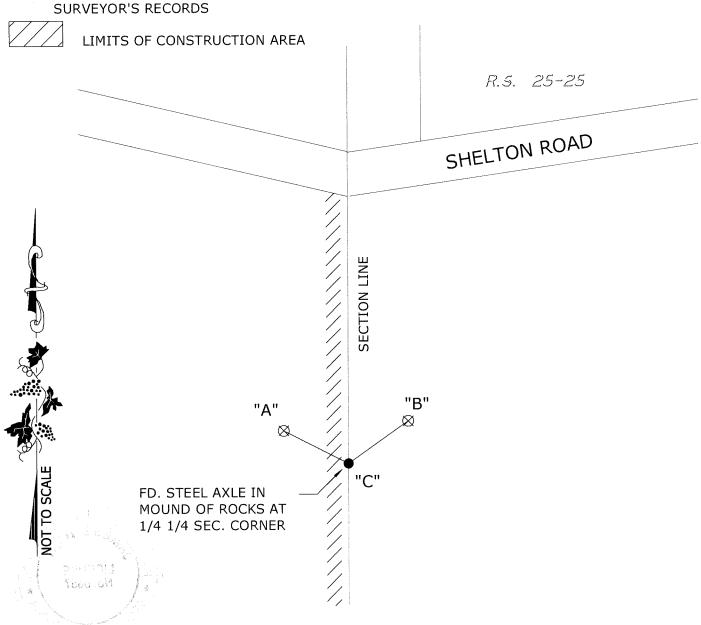

S:\Projects\2024\24015\3\_Drawings\24015\_CR dwg 05/07/25 1:56pm-CARTER-XREFS: 24015\_HC.dwg

BS-O-FS

A-C-B