
CORNER RECORD Agency Index Document Number San Joaquin City of Stockton County of , California Brief Legal Description Found chiseled x, no tag, on sidewalk and 2 mag nails on Kensington Way per CR-24-271 and a chiseled x, no tag, no record found. **COORDINATES (Optional) CORNER TYPE** Government Corner Control Elevation X U.S. Survey Foot Property Metric Meander Units Other **NAD 83** Rancho Horizontal Datum Zone 3 Epoch Date 1991.35 Date of Survey April 22, 2025 Vertical Datum ✓ Complies with Public Resources Code §§8801-8819 Complies with Public Resources Code §§8890-8902 8771 8773 PLS Act Ref.: 8765(d) X Other: Left as found Established Rebuilt **Pre-Construction** Corner/ Monument: Post-Construction Found and tagged Reestablished Referenced Narrative of corner identified and monument as found, set, reset, replaced, or removed: ✓ See sheet #2 for description(s): SURVEYOR'S STATEMENT This Corner Record was prepared by me or under my direction in conformance with CARINA G. SOLORIO the Professional Land Surveyors' Act on May 29, 2025 LS9916 P.L.S. or R.C.E. No. _____ Signed OF CALIFO **COUNTY SURVEYOR'S STATEMENT** This Corner Record was received

Page 1 of 2

County Surveyor's Comment



BPELSG-2016

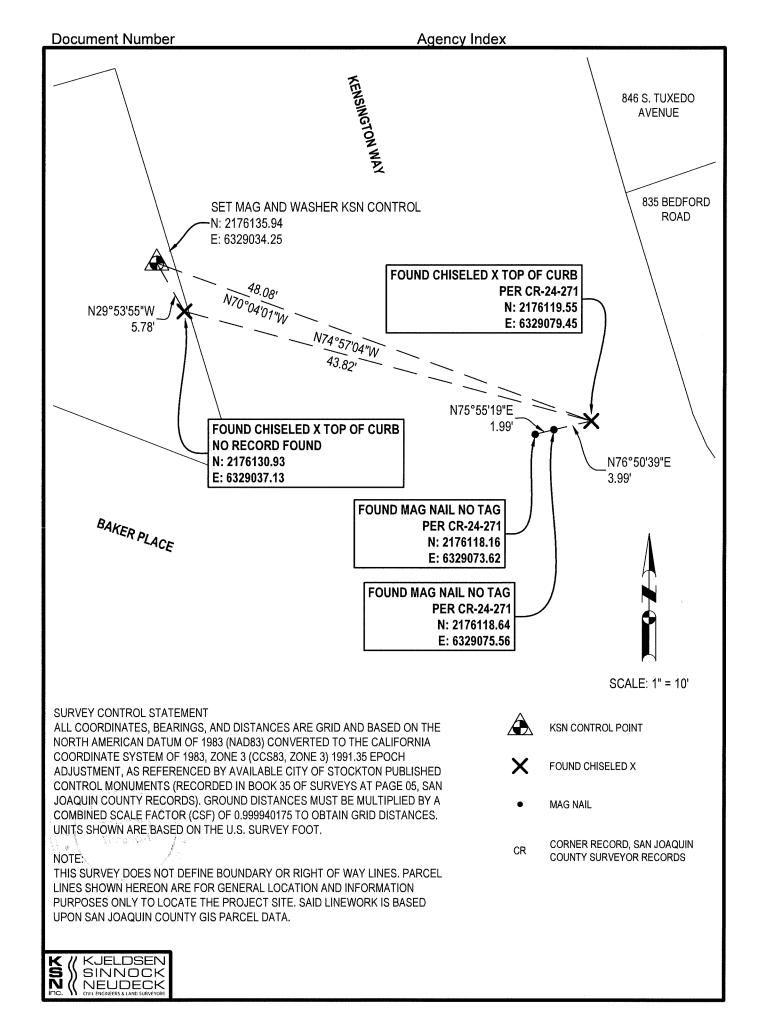

BPELSG-2016 Page 2 of 2