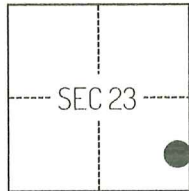


# CORNER RECORD

Agency Index

CR-25-223

Document Number

City of STOCKTON County of SAN JOAQUIN, CaliforniaBrief Legal Description FOUND MONUMENTS ALONG THE WESTERLY RIGHT OF WAY LINE OF SOUTH AIRPORT WAY, PER CR 24-321  
SAN JOAQUIN COUNTY SURVEYOR'S RECORDS.**CORNER TYPE****COORDINATES (Optional)**

C.M. WEBER GRANT

- ☐ Government Corner ☐ Control  
☐ Meander ☒ Property  
☐ Rancho ☐ Other

Date of Survey March 5, 2024

N. \_\_\_\_\_ E. \_\_\_\_\_

Elevation \_\_\_\_\_

Units ☐ Metric ☒ U.S. Survey Foot

Horizontal Datum \_\_\_\_\_

Zone \_\_\_\_\_ Epoch Date \_\_\_\_\_

Vertical Datum \_\_\_\_\_

☐ Complies with Public Resources Code §§8801-8819☐ Complies with Public Resources Code §§8890-8902PLS Act Ref.: ☐ 8765(d) ☒ 8771 ☐ 8773 ☐ Other:

Corner/  
Monument: ☐ Left as found ☐ Established ☐ Rebuilt ☐ Pre-Construction  
☐ Found and tagged ☒ Reestablished ☒ Referenced ☒ Post-Construction

Narrative of corner identified and monument as found, set, reset, replaced, or removed:

☒ See sheet #2 for description(s):

THE FOUND MONUMENT(S) SHOWN ON THIS CORNER RECORD WERE FOUND IN THE APPROXIMATE LOCATION OF THE CORNER(S) ON CR 24-321, SAN JOAQUIN COUNTY SURVEYOR'S RECORDS. I DID NOT VERIFY THE IDENTITY AND VALIDITY OF THE MONUMENT(S) FOUND AS ACTUALLY MARKING THE PROPERTY CORNER.

**SURVEYOR'S STATEMENT**

This Corner Record was prepared by me or under my direction in conformance with

the Professional Land Surveyors' Act on September 25, 2024.Signed Scott L. Blake P.L.S. or R.C.E. No. 8489**COUNTY SURVEYOR'S STATEMENT**This Corner Record was received June 11, 2025and examined and filed June 20, 2025.Signed James E. Hart P.L.S. or R.C.E. No. 8657Title County Surveyor

County Surveyor's Comment



Document Number

Agency Index

FOUND 3/4" REBAR  
STAMPED "PLS 8092" PER (A)

CR 24-321

S 17°30'47" E  
572.67' (M)

3437 S AIRPORT WAY  
APN: 177-020-78

N 34°15'22" E  
61.11' (M)

1/2" REBAR DISTURBED AND RESET  
WITH 5/8" REBAR WITH ALUMINUM CAP  
STAMPED "PLS 8489"

FOUND 5/8" REBAR WITH RED  
CONTROL CAP STAMPED "PLS 8489"

SOUTH AIRPORT WAY



NORTH

N.T.S.

BASIS OF BEARINGS IS ASSUMED

3462 S AIRPORT WAY  
APN: 177-153-54

CARPENTER ROAD

LEGEND



FOUND MONUMENT AS NOTED



FOUND CONTROL POINT

3462

REFERENCE STREET ADDRESS

APN


TAX ASSESSOR PARCEL NUMBER

CR

CORNER RECORD, SAN JOAQUIN COUNTY SURVEYOR'S RECORDS

(M)

MEASURED

 

TIE LINE



LOT LINE

REFERENCE

(A) CORNER RECORD 24-321, SAN JOAQUIN COUNTY SURVEYOR'S RECORDS