CR-25-225 Agency Index **CORNER RECORD Document Number** California SAN JOAQUIN County of STOCKTON City of Brief Legal Description FOUND MONUMENT(S) SHOWN ON CR-24-270, SAN JOAQUIN COUNTY SURVEYOR'S RECORDS. **COORDINATES (Optional) CORNER TYPE** N. Elevation Government Corner Control X U.S. Survey Foot Metric X Property Units Meander Other Horizontal Datum Rancho **Epoch Date** Zone February 7, 2024 Vertical Datum Date of Survey Complies with Public Resources Code §§8801-8819 C.M. WEBER GRANT Complies with Public Resources Code §§8890-8902 Other: 8773 X 8771 8765(d) PLS Act Ref.: Rebuilt Pre-Construction Established Left as found Corner/ X Post-Construction Referenced Reestablished Monument: Found and tagged Narrative of corner identified and monument as found, set, reset, replaced, or removed: See sheet #2 for description(s): THE FOUND MONUMENT(S) SHOWN ON THIS CORNER RECORD WERE FOUND AT THE LOCATION OF THE CORNER(S) ON CR 24-270, SAN JOAQUIN COUNTY SURVEYOR'S RECORDS. I DID NOT VERIFY THE IDENTITY AND VALIDITY OF THE MONUMENT(S) FOUND AS ACTUALLY MARKING THE PROPERTY CORNER. SURVEYOR'S STATEMENT This Corner Record was prepared by me or under my direction in conformance with No. 8489 October 8, 2024 the Professional Land Surveyors' Act\_on 8489 P.L.S. or R.C.E. No. OF CALIF COUNTY SURVEYOR'S STATEMENT

This Corner Record was received

June 11, 2025

and examined and filed

June 20, 2025

Signed

P.L.S. or R.C.E. No. 8657

Title


County Surveyor

County Surveyor's Comment

LICENSE No. 8657

Page 1 of 2

BPELSG-2016

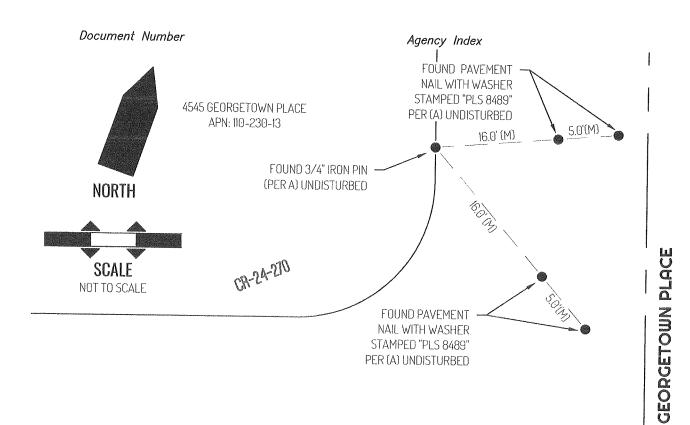

## **ROSE MARIE LANE**

LEGEND	
	FOUND MONUMENT AS NOTED
4545	REFERENCE STREET ADDRESS
CR	CORNER RECORD, SAN JOAQUIN COUNTY SURVEYOR'S RECORDS
APN	TAX ASSESSOR PARCEL NUMBER
(M)	MEASURED
	TIE LINE
· ·	LOT LINE.
	RIGHT-OF-WAY CENTERLINE

## REFERENCE

(A) CORNER RECORD 24-270, SAN JOAQUIN COUNTY SURVEYOR'S RECORDS