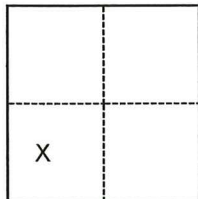


CORNER RECORD

Agency Index CR-25-234

Document Number _____

City of LODI County of SAN JOAQUIN, CaliforniaBrief Legal Description LOT 221, M.&P. 42-45, S.J.C.R.**CORNER TYPE****COORDINATES (Optional)**

- | | |
|--|--|
| <input type="checkbox"/> Government Corner | <input type="checkbox"/> Control |
| <input type="checkbox"/> Meander | <input checked="" type="checkbox"/> Property |
| <input type="checkbox"/> Rancho | <input type="checkbox"/> Other |

Date of Survey June 26, 2025

N. _____ E. _____

Elevation _____

Units ☐ Metric ☐ U.S. Survey Foot

Horizontal Datum _____

Zone _____ Epoch Date _____

Vertical Datum _____

☐ Complies with Public Resources Code §§8801-8819☐ Complies with Public Resources Code §§8890-8902PLS Act Ref.: ☐ 8765(d) ☒ 8771 ☐ 8773 ☐ Other:

Corner/ Monument:	<input checked="" type="checkbox"/> Left as found	<input type="checkbox"/> Established	<input type="checkbox"/> Rebuilt	<input checked="" type="checkbox"/> Pre-Construction
	<input type="checkbox"/> Found and tagged	<input type="checkbox"/> Reestablished	<input type="checkbox"/> Referenced	<input type="checkbox"/> Post-Construction

Narrative of corner identified and monument as found, set, reset, replaced, or removed:

☒ See sheet #2 for description(s):

SEE SHEET 2 OF 2 FOR MONUMENTS FOUND.


SURVEYOR'S STATEMENT

This Corner Record was prepared by me or under my direction in conformance with

the Professional Land Surveyors' Act on 07/08/2025Signed Walter John Shoup P.L.S. or R.C.E. No. L-7736**COUNTY SURVEYOR'S STATEMENT**This Corner Record was received July 8, 2025and examined and filed July 21, 2025Signed James E. Hart P.L.S. or R.C.E. No. 8657Title County Surveyor

County Surveyor's Comment _____



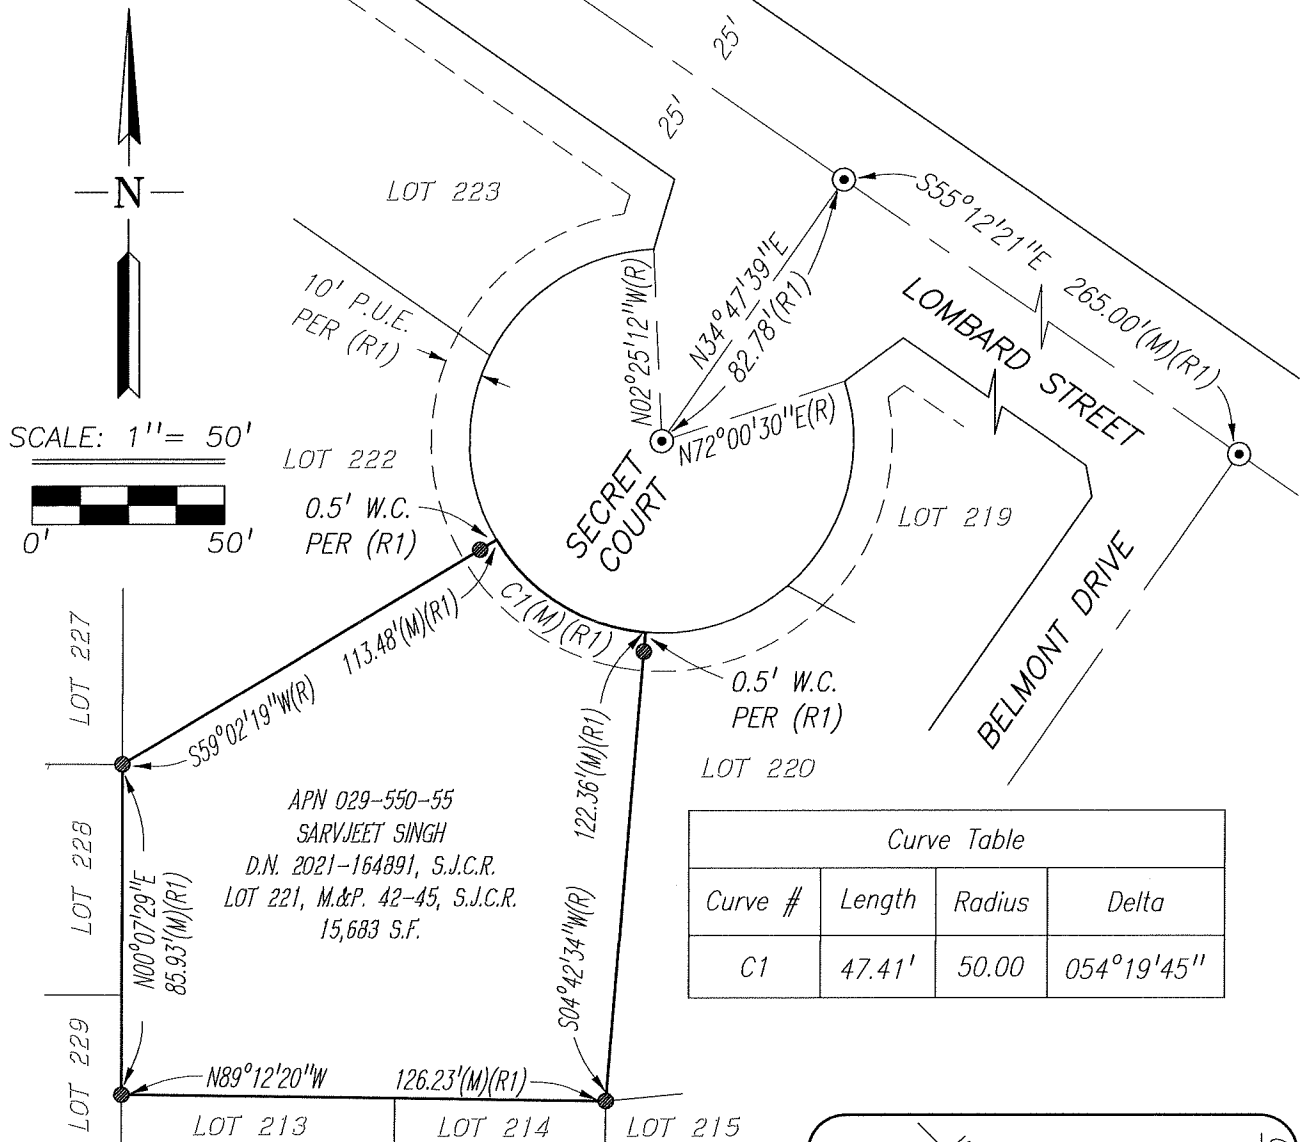

Curve Table			
Curve #	Length	Radius	Delta
C1	47.41'	50.00	054°19'45"

ABBREVIATIONS:


APN	ASSESSOR'S PARCEL NUMBER
D.N.	DOCUMENT NUMBER, S.J.C.R.
L.S.	LICENSED SURVEYOR
M.&P.	MAPS AND PLATS, BOOK-PAGE, S.J.C.R.
(M)	MEASURED
MON.	MONUMENT
P.U.E.	PUBLIC UTILITY EASEMENT
(R)	RADIAL BEARING
S.F.	SQUARE FEET
S.J.C.R.	SAN JOAQUIN COUNTY RECORDS
W.C.	WITNESS CORNER

MONUMENTS FOUND AND SET


- FD. 3/4" IRON PIPE TAGGED
L.S. 8159 PER (R1)
- FD. 3/4" IRON PIPE TAGGED
L.S. 8159 IN MON. WELL PER (R1)

REFERENCES:

(R1) M.&P. 42-45, S.J.C.R.

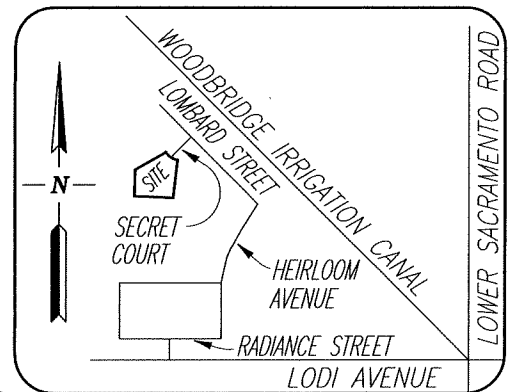**VICINITY MAP**

NO SCALE

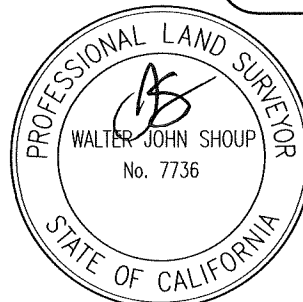

Scale: 1"=50'

Job No.: 25-110

CORNER RECORD

EXHIBIT MAP

Date: 07/07/2025

DWG: 25110CR.DWG