


# CORNER RECORD

Agency Index CR-25-243  
Document Number \_\_\_\_\_

City of STOCKTON County of SAN JOAQUIN, California  
Brief Legal Description FOUND MONUMENTS SHOWN ON CORNER RECORD 23-086 SAN JOAQUIN COUNTY SURVEYOR'S RECORDS.

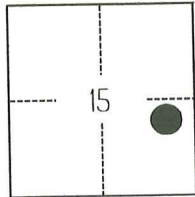

TIN/R6E

## CORNER TYPE

- ☐ Government Corner ☐ Control  
☐ Meander ☒ Property  
☐ Rancho ☐ Other

Date of Survey February 7, 2023

## COORDINATES (Optional)

N. \_\_\_\_\_ E. \_\_\_\_\_

Elevation \_\_\_\_\_

Units ☐ Metric ☒ U.S. Survey Foot

Horizontal Datum \_\_\_\_\_

Zone \_\_\_\_\_ Epoch Date \_\_\_\_\_

Vertical Datum \_\_\_\_\_

☐ Complies with Public Resources Code §§8801-8819

☐ Complies with Public Resources Code §§8890-8902

PLS Act Ref.: ☐ 8765(d) ☒ 8771 ☐ 8773 ☐ Other:

Corner/  
Monument: ☒ Left as found ☐ Established ☐ Rebuilt ☐ Pre-Construction  
☐ Found and tagged ☐ Reestablished ☒ Referenced ☒ Post-Construction

Narrative of corner identified and monument as found, set, reset, replaced, or removed:  
☒ See sheet #2 for description(s):

THE FOUND MONUMENT(S) SHOWN ON THIS CORNER RECORD WERE FOUND AT THE LOCATION OF THE CORNER(S) ON CR 23-086, SAN JOAQUIN COUNTY SURVEYOR'S RECORDS. I DID NOT VERIFY THE IDENTITY AND VALIDITY OF THE MONUMENT FOUND AS ACTUALLY MARKING THE PROPERTY CORNER.

## SURVEYOR'S STATEMENT

This Corner Record was prepared by me or under my direction in conformance with  
the Professional Land Surveyors' Act on October 9, 2024  
Signed Scott L. Blake P.L.S. or R.C.E. No. 8489




## COUNTY SURVEYOR'S STATEMENT

This Corner Record was received July 25, 2025  
and examined and filed August 12, 2025  
Signed James E. Hart P.L.S. or R.C.E. No. 8657  
Title County Surveyor



County Surveyor's Comment

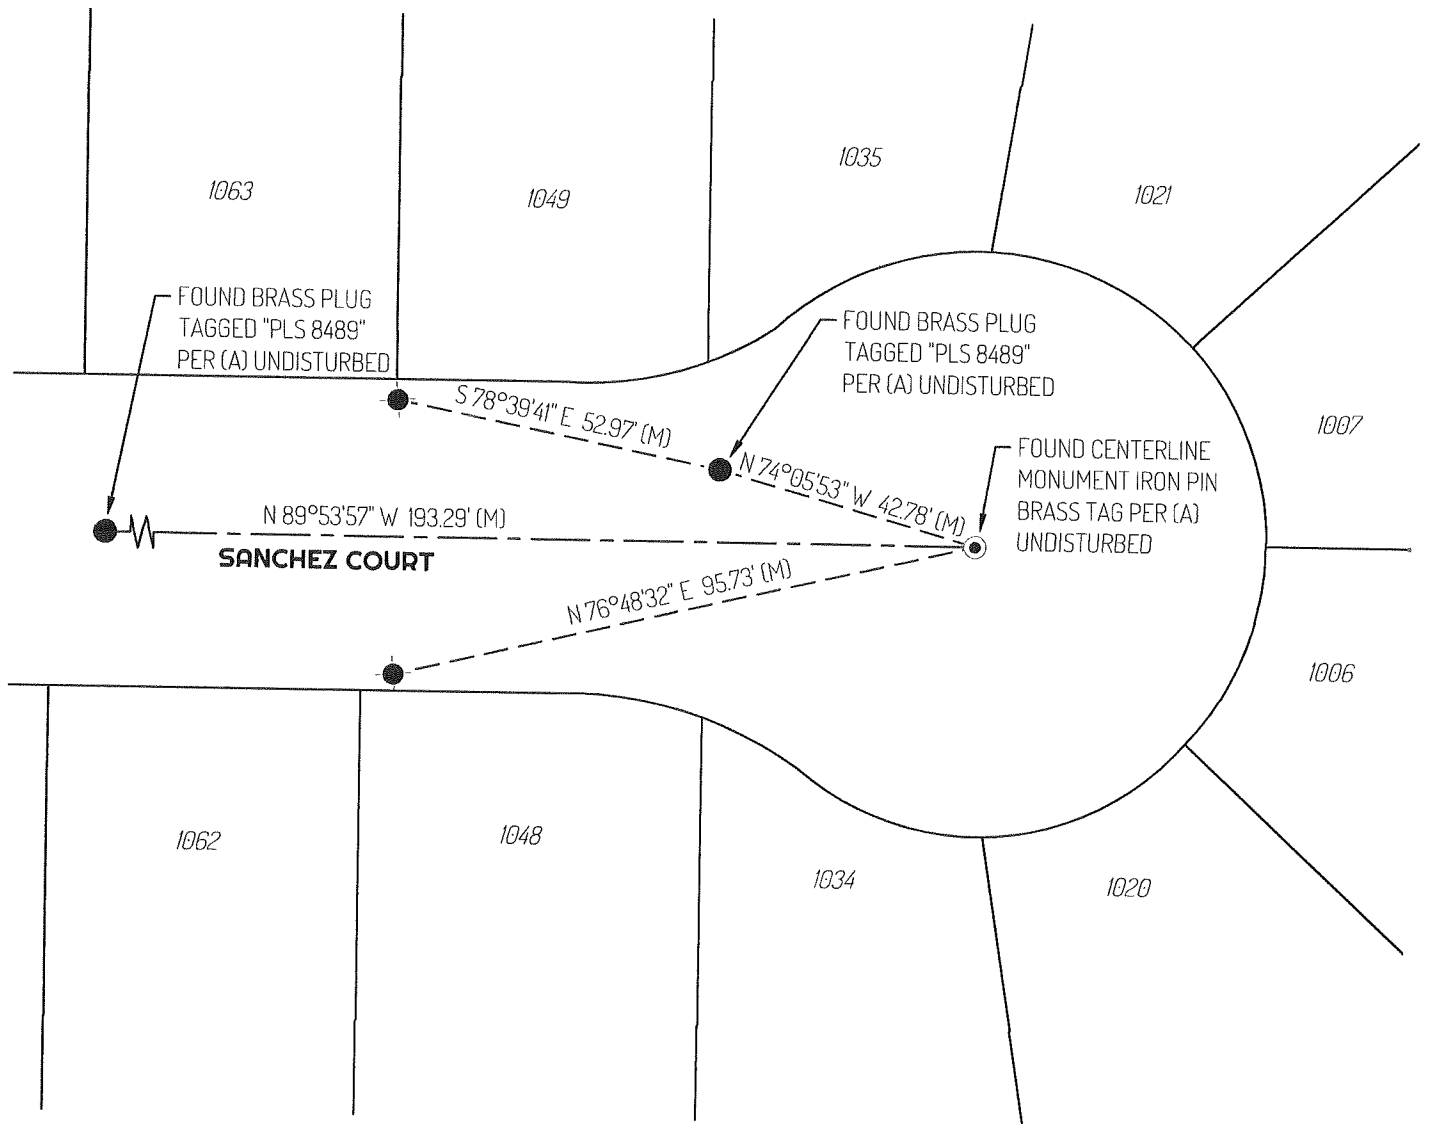

## LEGEND

- FOUND 3/4" IRON PIN TAGGED "RCE 8189" AS NOTED
- FOUND MONUMENT AS NOTED
- FOUND CHISELED CROSS PER (A) UNDISTURBED
- 1062 REFERENCE STREET ADDRESS
- (M) MEASURED
- - - - - TIE LINE
- — — — LOT LINE
- - - - - RIGHT OF WAY CENTERLINE

## REFERENCE

- (A) CORNER RECORD 23-086, SAN JOAQUIN COUNTY SURVEYOR'S RECORDS

