COR	NER F	RECO	RD	_	Index	CR-25	5-249
					ont Number		, California
	STOCK <sup>*</sup> Description		 OF BLOCK 28,		-		
CERTAIN UNR	ECORDED SURVE	Y CHW R-327	7, SAN JOAQU	IN COUNTY	SURVEYOR'S	RECORDS.	
	$\neg$	(	CORNER TY	PE	N	COORDINA	TES (Optional )
	G	Government Corn	er Contro		Elevation		
		<b>l</b> eander	Prope	ity [X]			U.S. Survey Foot
	F	Rancho	Other		Zone	Epoch Da	ate
	[	ate of Survey	9/9/2024				
			,				es Code §§8801-8819 es Code §§8890-8902
PLS Act Ref:	□ 8765(d)	──────────────────────────────────────	71	8773		□ 0	ther:
Corner/	X Left as four	nd 🗌 Es	tablished	Rebu	ilt	X P	re-Construction
Monument:	☐ Found and	tagged  Re	established	X Refer	renced	□Р	ost-Construction
LINE OF LO	OT 6, BLOCK JIN COUNTY R	28 STOCKTO	ON CITY HON	MESTEAD	ASSOCIATIC	ON, MP 2-	THE NORTHERLY
	SUR	VEYOR'S ST	TATEMENT				CARIES S
This Corner R	Record was prepa	red by me or u	nder my directi	on in confo	rmance with		9.7
the Profession	nal Land Surveyo	rs' Act on	7/7/	2025	-		. 6148 🤾 🕯
Signed	LESTER E. CA	DTED ID	P.L.S. N	o6	148	No.	OF CALIFORNIA
	LESTER E. CA	IKTENJIK.					Warren .
		SURVEYOR	1 - 1 - 1 - 1 - 1 - 1 - 1 - 1 - 1 - 1 -			//	ONAL LAND
	Record was receiv						THES E. ALLE
and examined	d and filed	July 25	, 2025		0.150	PRO	LICENSE S
Signed	amo Z A	art	P.L.S. <del>or</del>	<del>R.C.</del> E. No.	8657	(*/	No. 8657
Title	ounty Sur	veyor					E OF CALIFORNIA
County Surve	yor's Comment_						
-							


## **STATEMENT OF PURPOSE:**

THE PURPOSE OF THIS SURVEY IS TO IDENTIFY AND RECORD THE LOCATION OF EXISTING MONUMENTS PRIOR TO THE CONSTRUCTION OF PG&E FACILITIES AROUND THE MONUMENTS. THIS SURVEY DOES NOT ATTEMPT TO MAKE ANY PROPERTY LINE DETERMINATIONS. LOT LINES SHOWN HEREON ARE FOR GENERAL LOCATION AND INFORMATIONAL PURPOSES ONLY.

## DATUM STATEMENT:

COORDINATES SHOWN HEREON ARE GRID AND ARE BASED ON CITY OF STOCKTON MONUMENT 30, CALIFORNIA COORDINATE SYSTEM(CCS83). ZONE III, 1983 NAD, AND SHOWN ON RECORD OF SURVEY BOOK 35 OF SURVEYS, PAGE 5. THE PROJECT SPECIFIC COMBINED SCALE FACTOR IS 0.99993834.

## **LEGEND**

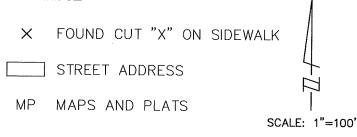

GRID COORDINATES (U.S. FEET)						
POINT#	NORTHING	EASTING				
200001	2163343.583	6335429.939				

