CORI	NER	RECC	ORD		y Index ent Number	_CR-25-	-253
City of	STO	CKTON					, California
Brief Legal AND 49, OF 7	Descriptio THE C.M. WE		AS SHOWN ON	OF LOT 2 N THAT CI	1 ON A PARC ERTAIN MAP F	CEL MAP, LYING	IN SECTIONS 48
j.			CORNER TY	PE	N.	COORDINATI E.	ES (Optional)
		Government Con Meander Rancho Date of Survey_	Control Prope Other	rty 🔀	Elevation _ Units Horizontal Dat Zone _ Vertical Datun Complies with	Metric	J.S. Survey Foot X Code §§8801-8819 Code §§8890-8902
PLS Act Ref:	☐ 8765(d)	☒ 8	771	□ 8773	3	Othe	ər:
Corner/ Monument:	X Left as f ☐ Found a	ound	stablished leestablished	☐ Reb		_	Construction t-Construction
INTERSECTION 123	ON OF BOE 3, SAN JOA SI	ING WAY AND QUIN COUNTY	WEST FRON' RECORDS.	TAGE RC	OAD AS SHO	OWN ON SAID	LAND SUPPLY CARTERS
		epared by me or			ormance with	*	70 ★
the Profession Signed	Julus	eyors' Act on	P.L.S. No.	7/2025 o	6148	V. 7. 7. 7. 7. 7. 7. 7. 7. 7. 7. 7. 7. 7.	6148
		Y SURVEYOR					MALLAND
This Corner R	ecord was re	ceived	14 21, 20	25			MES E. ALZO
and examined	and filed	July 25,	2025			PROF	LICENSE S
Signed	ounty Sc	July 25, fat	P.L.S. or	R.C.E . No	_{0.} 8657	(C. TATE	No. 8657
County Survey	yor's Comme	nt	3				

Page 1 of 2

BPELSG-2016


STATEMENT OF PURPOSE:

THE PURPOSE OF THIS SURVEY IS TO IDENTIFY AND RECORD THE LOCATION OF EXISTING MONUMENTS PRIOR TO THE CONSTRUCTION OF PG&E FACILITIES AROUND THE MONUMENTS. THIS SURVEY DOES NOT ATTEMPT TO MAKE ANY PROPERTY LINE DETERMINATIONS. LOT LINES SHOWN HEREON ARE FOR GENERAL LOCATION AND INFORMATIONAL PURPOSES ONLY.

DATUM STATEMENT:

COORDINATES SHOWN HEREON ARE GRID AND ARE BASED ON CITY OF STOCKTON MONUMENTS 179 AND 336, CALIFORNIA COORDINATE SYSTEM(CCS83). ZONE III, 1983 NAD, AND SHOWN ON RECORD OF SURVEY BOOK 35 OF SURVEYS, PAGE 5. THE PROJECT SPECIFIC COMBINED SCALE FACTOR IS 0.99993635.

LEGEND

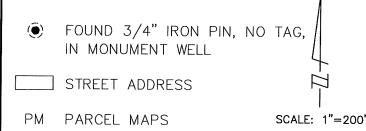

GRID COORDINATES (U.S. FEET)					
POINT#	NORTHING	EASTING			
11303	2155166.382	6352230.622			

