CORI	NER	RECC	)RD	_	icy Index Iment Number	(K-2	55-231
City of	STOC	KTON	OF THE MODELIN	Coun	ty of SAN	JOAQUIN	, California
M. D. B. & N	1., AS SHOWI	n A PORTION ON THAT CER COUNTY RECORD	RTAIN MAP FILED	JUNE	/4 OF SECTION 11, 2019 IN B	00K 26 0F	PARCEL MAPS, AT
			CORNER TY	PE	N	COORDINA	TES (Optional )
		Government Con Meander Rancho Date of Survey_	rner Contro Proper Other	rty	Elevation Units Horizontal Date Zone Vertical Datum	Metric  umEpoch Da	EU.S. Survey Foot 🖾
	—			<u> </u>	•		es Code §§8890-8902
PLS Act Ref: Corner/ Monument:	☐ 8765(d) ☐ Left as f ☐ Found a		stablished	<ul><li></li></ul>		X P	ther: re-Construction ost-Construction
See sheet APPEARS TO 26-PM-139. APPEARS TO	#2 for descri BE AN ANGL FOUND 3/4 THE CORNER INTERSECTION	ption(s): FOUN .E POINT FOR T " REBAR WITH ( R SHOWN ON TH N OF THE 45' I	D 3/4" IRON HE PARCEL LAB CAP STAMPED L HE LINE COMMO	PIN, NO ELED A S 9032 N TO S	olaced, or remove O TAG, ON NOR AS "DESIGNATED ON THE NORT SAID "DESIGNATE OR SAID MAP 26	TH SIDE OF REMAINDER" H SIDE OF A D REMAINDEF	RCH RD. THAT
This Corner D		JRVEYOR'S Separed by me or		on in co	nformance with	30/1	CANZA SIS
	al Land Surve	eyors' Act on		9/2025			6. 6148 OF CALIFORNIA
T.: 0		eived				//2	SONAL LAND
						PROFE	AME TO SERVICE
Signed Signed	and med_	Hart	P.L.S. <del>or</del>	R.C.E.	No. 8657	(S.)	LICENSE No. 8657
	,	nt					FOF CALIFORN

Docume	nt N	umber
--------	------	-------

Agency Index


## STATEMENT OF PURPOSE:

THE PURPOSE OF THIS SURVEY IS TO IDENTIFY AND RECORD THE LOCATION OF EXISTING MONUMENTS PRIOR TO THE CONSTRUCTION OF PG&E FACILITIES AROUND THE MONUMENTS. THIS SURVEY DOES NOT ATTEMPT TO MAKE ANY PROPERTY LINE DETERMINATIONS. LOT LINES SHOWN HEREON ARE FOR GENERAL LOCATION AND INFORMATIONAL PURPOSES ONLY.

## **DATUM STATEMENT:**

COORDINATES SHOWN HEREON ARE GRID AND ARE BASED ON CITY OF STOCKTON MONUMENTS 179 AND 336, CALIFORNIA COORDINATE SYSTEM(CCS83). ZONE III, 1983 NAD, AND SHOWN ON RECORD OF SURVEY BOOK 35 OF SURVEYS, PAGE 5. THE PROJECT SPECIFIC COMBINED SCALE FACTOR IS 0.99993635.

## **LEGEND**

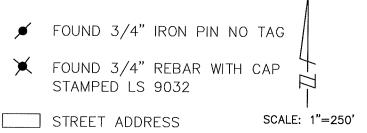

GRID COORDINATES (U.S. FEET)							
POINT#	NORTHING	EASTING					
11309	2152938.451	6359154.004					
11310	2152901.424	6359917.124					

PM PARCEL MAP
MP MAPS AND PLATS

APN ASSESSOR'S PARCEL NUMBER

