CORI	NER	RECO	ORD				CR-25-258	
City of								, California
Brief Legal	Description AND AS SHO	n a portio Dwn on that	CERTAIN MAR	DUTHWEST	1/4 OF	SECTION	27, T. 1 N.,	
	, _		CORNER	TYPE	N	ï	COORDINA	TES (Optional)
		Government of Meander Rancho Date of Surve		Control Property Other 2024	Elev Unit Hori Zon Vert	vation s zontal Datu e ical Datum plies with P	Metric umEpoch Dai Public Resource	U.S. Survey Foot 🗵 te s Code §§8801-8819 s Code §§8890-8902
PLS Act Ref:	☐ 8765(d)	X	8771		8773		☐ Ot	her:
Corner/ Monument:	X Left as f ☐ Found a	ound \Box	Established Reestablishe		Rebuilt Referenc	ed		e-Construction st-Construction
APPEARS TO E	BE THE CORI PPEARS TO I D CUT "X" C 2 AND 3. FC ORNER COMM COUNTY REC	NER COMMON BE THE NORTI ON THE SOUTH OUND CUT "X" MON TO PARC	TO PARCELS HWESTERLY F I SIDE OF AF ON THE SO ELS 1 AND 2	3 AND 4 POINT OF C RCH ROAD UTH SIDE PER SAID	. FOUND CURVATUR THAT AF OF ARCH	CUT "X' RE OF A PPEARS TO I ROAD T	ON THE SOU DRIVEWAY FO D BE THE CO HAT APPEARS	RNER COMMON
This Corner Re	ecord was pre	epared by me o	or under my di	rection in c	onforma	nce with		
the Profession	Julus	()	P.L.S	7/7/2025 S. No	6148	<u> </u>		6148 OF CALLY OR
	COUNT	Y SURVEY	OR'S STAT	EMENT				WAL LAND
This Corner Re			<i>July</i> 21,	2025				MES E. ALOSE
and examined	and filed	July Z	5, 202	5			PRO)	LICENSE TO
Signed	mes I &	Jat	P.L.\$	S. o r R.C.E	. No &	657	*STRIKE	OF CALIFORNIA
County Survey	or's Commer	nt						

STATEMENT OF PURPOSE:


THE PURPOSE OF THIS SURVEY IS TO IDENTIFY AND RECORD THE LOCATION OF EXISTING MONUMENTS PRIOR TO THE CONSTRUCTION OF PG&E FACILITIES AROUND THE MONUMENTS. THIS SURVEY DOES NOT ATTEMPT TO MAKE ANY PROPERTY LINE DETERMINATIONS. LOT LINES SHOWN HEREON ARE FOR GENERAL LOCATION AND INFORMATIONAL PURPOSES ONLY.

DATUM STATEMENT:

COORDINATES SHOWN HEREON ARE GRID AND ARE BASED ON CITY OF STOCKTON MONUMENTS 179 AND 336, CALIFORNIA COORDINATE SYSTEM(CCS83). ZONE III, 1983 NAD, AND SHOWN ON RECORD OF SURVEY BOOK 35 OF SURVEYS, PAGE 5. THE PROJECT SPECIFIC COMBINED SCALE FACTOR IS 0.99993635.

LEGEND

APN

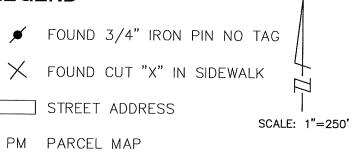

ASSESSOR'S PARCEL NUMBER

GRID COORDINATES (U.S. FEET) POINT# **NORTHING** EASTING 11311 2152805.038 6359557.409 11312 2152795.880 6360117.398 11313 2152795.872 6360166.206 11314 2152796.042 6360839.352

APN 181–100–19 VACANT LAND

APN 181-100-18 VACANT LAND

