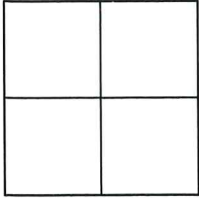


# CORNER RECORD

Agency Index CR-25-264

Document Number \_\_\_\_\_

City of LODICounty of SAN JOAQUIN, CaliforniaBrief Legal Description CITY OF LODI BENCHMARK # 1040**CORNER TYPE**

- ☐ Government Corner ☒ Control  
☐ Meander ☐ Property  
☐ Rancho ☐ Other

Date of Survey 6-5-2025**COORDINATES (Optional)**

N. \_\_\_\_\_ E. \_\_\_\_\_

Elevation \_\_\_\_\_

Units Metric ☐ U.S. Survey Foot ☐

Horizontal Datum \_\_\_\_\_

Zone \_\_\_\_\_ Epoch Date \_\_\_\_\_

Vertical Datum \_\_\_\_\_

☐ Complies with Public Resources Code §§8801-8819☐ Complies with Public Resources Code §§8890-8902PLS Act Ref: ☐ 8765(d) ☒ 8771 ☐ 8773 ☐ Other:

Corner/Monument: ☒ Left as found ☐ Established ☐ Rebuilt ☐ Pre-Construction  
☐ Found and tagged ☐ Reestablished ☒ Referenced ☐ Post-Construction

Narrative of corner identified and monument as found, set, reset, replaced, or removed:

☒ See sheet #2 for description (s):

FOUND CITY BENCHMARK # 1040. THIS POINT WAS REFERENCED PRIOR TO A CONSTRUCTION PROJECT IN THE VICINITY. THE TIES SHOWN HEREON ARE FOR THE PURPOSE OF PERPETUATING FOUND MONUMENTATION. NO CLAIM IS MADE AS TO THE RELATIONSHIP OF THE POINTS OR LINES SHOWN HEREON. REFERENCE ELEVATIONS SHOWN ARE DERIVED FROM HOLDING CITY OF LODI BENCHMARK (NGVD 29) WITH A PUBLISHED ELEVATION OF 53.26.

**SURVEYOR'S STATEMENT**


This Corner Record was prepared by me or under my direction in conformance with the Professional Land Surveyors' Act on 6-9-2025


Signed [Signature] P.L.S. or R.C.E. No. LS 9384**COUNTY SURVEYOR'S STATEMENT**This Corner Record was received August 11, 2025and examined and filed August 12, 2025Signed James E. Hart P.L.S. or R.C.E. No. 8657Title County Surveyor

County Surveyor's Comment


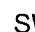

**LEGEND**

These standard symbols will  
be found in the drawing.




FOUND 2 1/2" BRASS DISC SET IN TOP OF CURB   
MARKED CITY OF LODI BENCH MARK

SET 1/2" BRASS TAG LS 9384 RP 

EDGE OF CONCRETE 



BACK OF SIDEWALK  SW  SW 

TIE LINES 

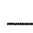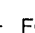 TOP FACE OF CURB  FC  FC 


DRIVE WAY  D/W

ASSESSOR PARCEL NUMBER  APN

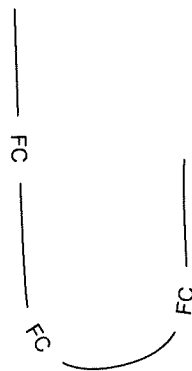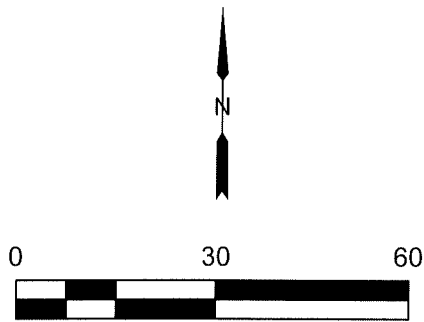

230 N CHEROKEE LANE  
APN: 043-210-57

BENCH MARK ELEVATION PER CITY OF  
LODI BENCHMARK (NGVD 29) FOUND ON  
CITY OF LODI WEBSITE.

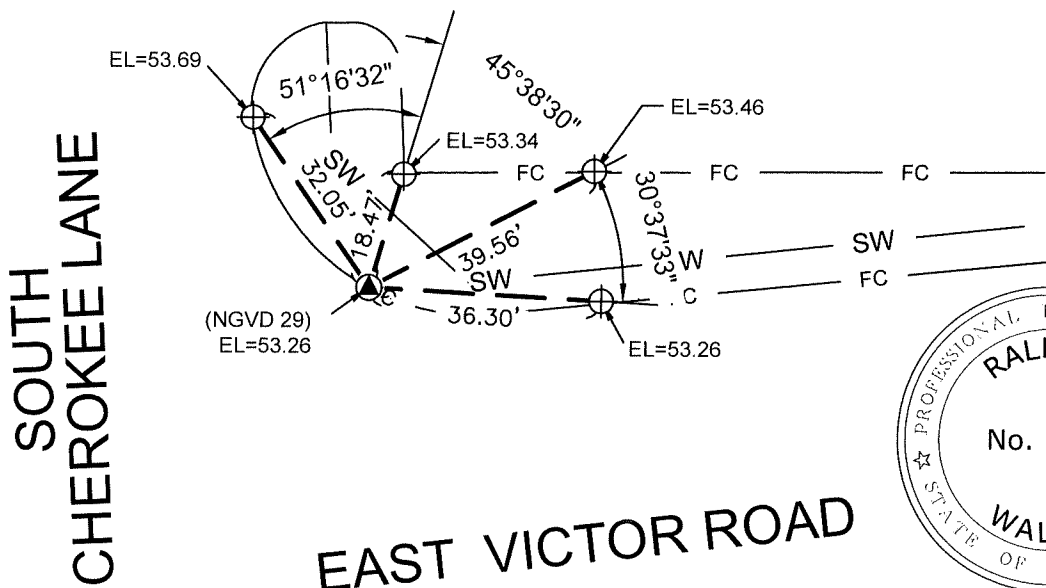

DISTANCES ARE IN FEET  
AND DECIMAL THERE OF.

