
	100			
00		ER	$\boldsymbol{\cap}$	

Document Number City of UNINCORPORATED County of SAN JOAQUIN LA SALLE ST. & INDIANA ST., 26 M&P 28, S.J.C. RECORDS Brief Legal Description **COORDINATES (Optional) CORNER TYPE** E. Elevation Government Corner Control X X U.S. Survey Foot Meander Property Units Metric Rancho X Other Horizontal Datum Zone Epoch Date Date of Survey June 25, 2025 Vertical Datum Complies with Public Resources Code §§8801-8819 T4N.,R 6E. Complies with Public Resources Code §§8890-8902 **X** 8771 8773 Other: PLS Act Ref.: 8765(d) Rebuilt **Pre-Construction** Left as found Established Corner/ Monument: Post-Construction X Referenced Found and tagged Reestablished Narrative of corner identified and monument as found, set, reset, replaced, or removed: See sheet #2 for description(s): FOUND 3/4" REBAR W/ TAG STAMPED "RCE 19638" IN MONUMENT WELL AT THE INTERSECTION OF LA SALLE STREET AND INDIANA STREET, AS SHOWN ON TRACT No. 1622 COUNTRY VIEW SUBDIVISION, UNIT NO. 1, 26 M&P 28, S.J.C. RECORDS. SURVEYOR'S STATEMENT This Corner Record was prepared by me or under my direction in conformance with the Professional Land Surveyors' Act on July 8, 2025 8474 No. 8474 **COUNTY SURVEYOR'S STATEMENT** July 28, 2025 This Corner Record was received and examined and filed LICENSE Signed Title

County Surveyor's Comment

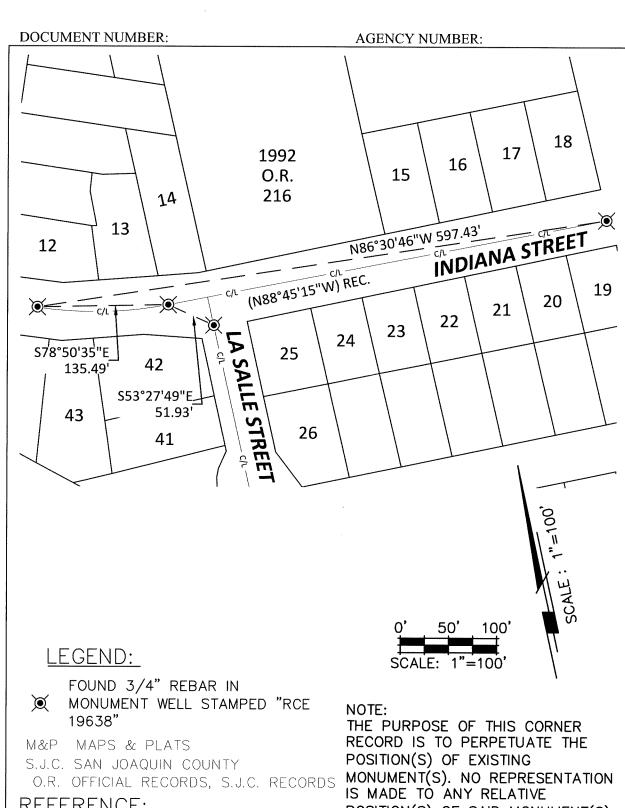

REFERENCE:

26 M&P 28, S.J.C. RECORDS

POSITION(S) OF SAID MONUMENT(S). ALL RIGHT OF WAY, PROPERTY LINES, CENTERLINES AND OTHERS ARE FOR GRAPHICAL REPRESENTATION ONLY.



CORNER RECORD EXHIBIT MAP

SCALE: 1"=100' JOB NO: 35645743 DATE: 7/08/2025 DWG: INDIANA STREET