
## CORNER RECORD

Document Number County of SAN JOAQUIN City of Brief Legal Description PRE-CONSTRUCTION TIES FOR MONUMENT PRESERVATION **CORNER TYPE COORDINATES (Optional)** E. Government Corner X Control Elevation X U.S. Survey Foot Units Meander Property Metric Rancho Other Horizontal Datum Zone Epoch Date Date of Survey July 14, 2025 Vertical Datum Complies with Public Resources Code §§8801-8819 Complies with Public Resources Code §§8890-8902 X Other: PLS Act Ref.: 8765(d) 8771 Pre-Construction Left as found Established Rebuilt Corner Monument: Post-Construction Found and tagged Reestablished Referenced Narrative of corner identified and monument as found, set, reset, replaced, or removed: See sheet #2 for description(s): PRE-CONSTRUCTION TIES FOR MONUMENT PRESERVATION ON FARMINGTON ROAD, STATE ROUTE 4. NEAR INTERSECTION WITH WALKER LANE SURVEYOR'S STATEMENT This Corner Record was prepared by me or under my direction in conformance with the Professional Land Surveyors' Act on July 16, 2025 \_ Coul & Boty \_\_P.L.S. PLS 5650 COUNTY SURVEYOR'S STATEMENT August 21, 2025 This Corner Record was received August 29, 2025.

P.L.S. OFR.C.E. No. 8657 and examined and filed LICENSE Signed No. 8657 Title **County Surveyor's Comment** 

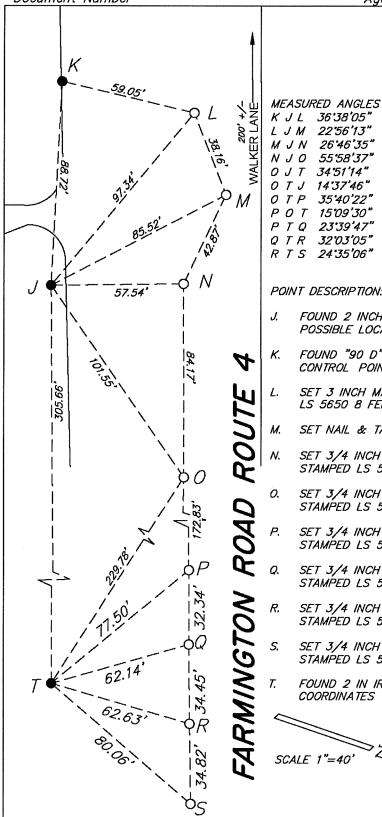

- SET MONUMENT
- FOUND MONUMENT

## POINT DESCRIPTION:

*55\*58'37"* 

34\*51'14" 14'37'46" 35'40'22" O T 15'09'30" 23'39'47" 32'03'05"

NJO

- FOUND 2 INCH IRON PIPE UP 1' LEANING USED BASE POSSIBLE LOCATION PER RECORD OF SURVEY 18-24
- FOUND "90 D" NAIL UP 1 INCH & LOOSE CALTRANS CONTROL POINT #10
- SET 3 INCH MAG SPIKE AND WASHER STAMPED LS 5650 8 FEET NORTH OF EDGE OF PAVEMENT.
- SET NAIL & TAG L.S. 5650 IN POWER POLE UP 3' М.
- SET 3/4 INCH IRON PIPE & YELLOW PLASTIC CAP STAMPED LS 5650 3 FT NORTH OF EDGE PAVEMENT
- SET 3/4 INCH IRON PIPE & YELLOW PLASTIC CAP STAMPED LS 5650 3 FT NORTH OF EDGE PAVEMENT
- SET 3/4 INCH IRON PIPE & YELLOW PLASTIC CAP STAMPED LS 5650 3 FT NORTH OF EDGE PAVEMENT
- Q. SET 3/4 INCH IRON PIPE & YELLOW PLASTIC CAP STAMPED LS 5650 3 FT NORTH OF EDGE PAVEMENT
- SET 3/4 INCH IRON PIPE & YELLOW PLASTIC CAP STAMPED LS 5650 3 FT NORTH OF EDGE PAVEMENT
- S. SET 3/4 INCH IRON PIPE & YELLOW PLASTIC CAP STAMPED LS 5650 3 FT NORTH OF EDGE PAVEMENT
- Т. FOUND 2 IN IRON FENCE POST FITS CALTRANS **COORDINATES**

