
CORNER RECORD

Document Number City of _____ STOCKTON ____ County of ___ SAN JOAQUIN Brief Legal Description LOTS 10, 12, 15 & 16 OF BLOCK 112, SOUTH OF MORMON CHANNEL **CORNER TYPE COORDINATES (Optional)** Government Corner Control Elevation Meander Property Units U.S. Survey Foot Metric Other Rancho Horizontal Datum Zone Epoch Date Date of Survey April 22, 2024 Vertical Datum Complies with Public Resources Code §§8801-8819 T.2S., R.8E., SEC 19 Complies with Public Resources Code §§8890-8902 PLS Act Ref.: × 8765(d) 8771 8773 Other: Left as found Established Rebuilt Corner/ Pre-Construction Monument: Found and tagged Reestablished Referenced Post-Construction Narrative of corner identified and monument as found, set, reset, replaced, or removed: ✓ See sheet #2 for description(s): MONUMENTS TIED OUT PRIOR TO CONSTRUCTION. SURVEYOR'S STATEMENT This Corner Record was prepared by me or under my direction in conformance with the Professional Land Surveyors' Act on September 4, 2025 Signed P.L.S. or R.C.E. No. 8656 **COUNTY SURVEYOR'S STATEMENT** and filed <u>September 15, 2025</u> and filed <u>September 30, 2025</u>.

P.L.S. or R.C.E. No. <u>8657</u> This Corner Record was received and examined and filed Signed Title

Agency Index

County Surveyor's Comment

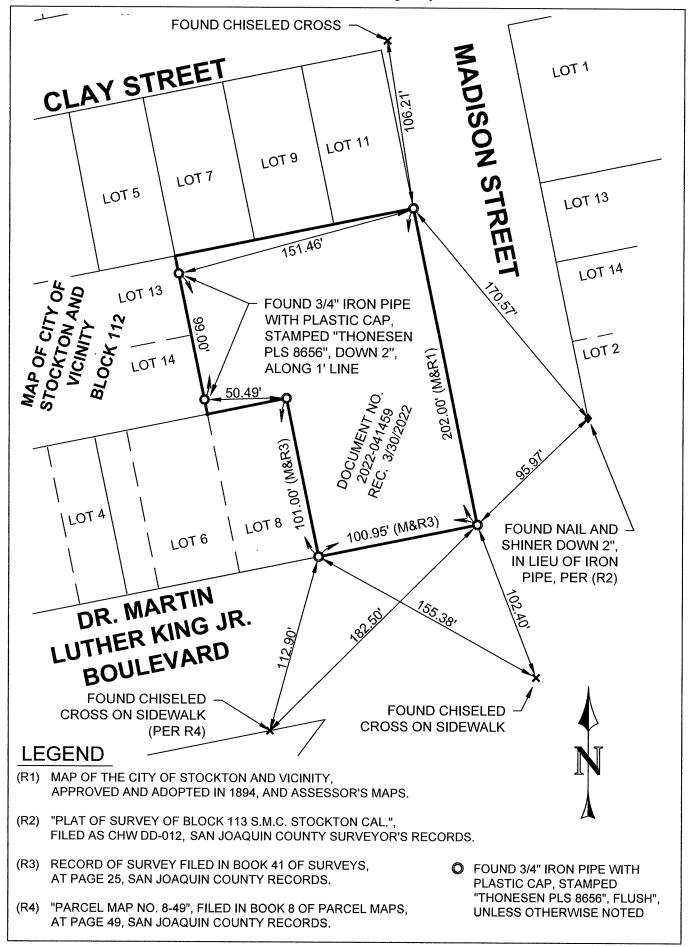

BPELSG-2016 Page 2 of 2