CORNER RECORD

Document Number City of County of SAN JOAQUIN Brief Legal Description FOUND MONUMENTS ALONG THE EASTERLY RIGHT-OF-WAY LINE OF SOUTH 99 FRONTAGE ROAD EAST SAN JOAQUIN COUNTY SURVEYOR'S RECORDS **COORDINATES (Optional) CORNER TYPE** N. Government Corner Control Elevation X U.S. Survey Foot Meander Property Units Metric SEC 59 ---Rancho Other **Horizontal Datum Epoch Date** Zone Date of Survey March 27, 2025 Vertical Datum Complies with Public Resources Code §§8801-8819 C.M. WEBER GRANT Complies with Public Resources Code §§8890-8902 **X** 8771 8773 Other: **PLS Act Ref.:** 8765(d) Left as found Rebuilt ☐ Pre-Construction Established Corner/ **Monument:** Referenced Post-Construction Found and tagged Reestablished Narrative of corner identified and monument as found, set, reset, replaced, or removed: See sheet #2 for description(s): THE FOUND MONUMENT(S) SHOWN ON THIS CORNER RECORD WERE FOUND AT THE LOCATION OF THE CORNER(S) ON CR- 24-161. SAN JOAQUIN COUNTY SURVEYOR'S RECORDS. I DID NOT VERIFY THE IDENTITY AND VALIDITY OF THE MONUMENT(S) FOUND AS ACTUALLY MARKING THE PROPERTY CORNER. **SURVEYOR'S STATEMENT** This Corner Record was prepared by me or under my direction in conformance with No. 8489 the Professional Land Surveyors' Act on April 3, 2025 Signed P.L.S. or R.C.E. No. OF CALL **COUNTY SURVEYOR'S STATEMENT** September 26, 2025
September 30, 2025


Har P.L.S. OFR.C.E. No. 8657 This Corner Record was received and examined and filed LICENSE Signed No. 8657 Title

Page 1 of 2

CR-25-296

Agency Index

County Surveyor's Comment

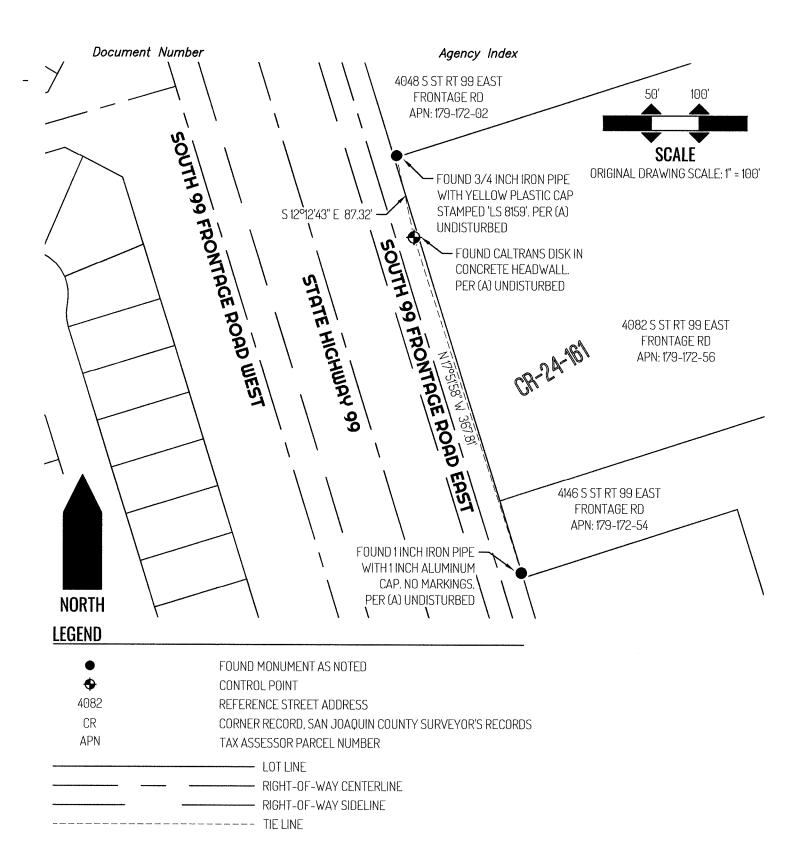


(A)

CORNER RECORD 24-161, SAN JOAQUIN COUNTY SURVEYOR'S RECORDS