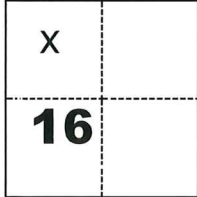


CORNER RECORD

Agency Index

CR-25-301

Document Number

City of _____ County of SAN JOAQUIN, CaliforniaBrief Legal Description LOT 28 OF 11 M&P 19. S.J.C.R.**CORNER TYPE****COORDINATES (Optional)**

- ☐ Government Corner ☐ Control
☐ Meander ☒ Property
☐ Rancho ☐ Other

Date of Survey August 10, 2025

N. _____ E. _____

Elevation _____

Units ☐ Metric ☒ U.S. Survey Foot

Horizontal Datum _____

Zone _____ Epoch Date _____

Vertical Datum _____

☐ Complies with Public Resources Code §§8801-8819☐ Complies with Public Resources Code §§8890-8902T2N., R6E.

PLS Act Ref.:

☐ 8765(d)☒ 8771☐ 8773☐ Other:Corner/
Monument:☒ Left as found☐ Established☐ Rebuilt☒ Pre-Construction☐ Found and tagged☐ Reestablished☒ Referenced☐ Post-Construction

Narrative of corner identified and monument as found, set, reset, replaced, or removed:

☒ See sheet #2 for description(s):

FOUND 1" IRON PIPE, NO TAG, ON THE NORTHWEST BOUNDARY LINE OF LOT 28, 11 M&P 19, SAN JOAQUIN COUNTY RECORDS. See Map on page 2 of this corner record.


SURVEYOR'S STATEMENT

This Corner Record was prepared by me or under my direction in conformance with

the Professional Land Surveyors' Act on August 15, 2025Signed  (P.L.S.) or R.C.E. No. 8474**COUNTY SURVEYOR'S STATEMENT**This Corner Record was received September 15, 2025and examined and filed September 30, 2025Signed  P.L.S. or R.C.E. No. 8657Title County Surveyor

County Surveyor's Comment

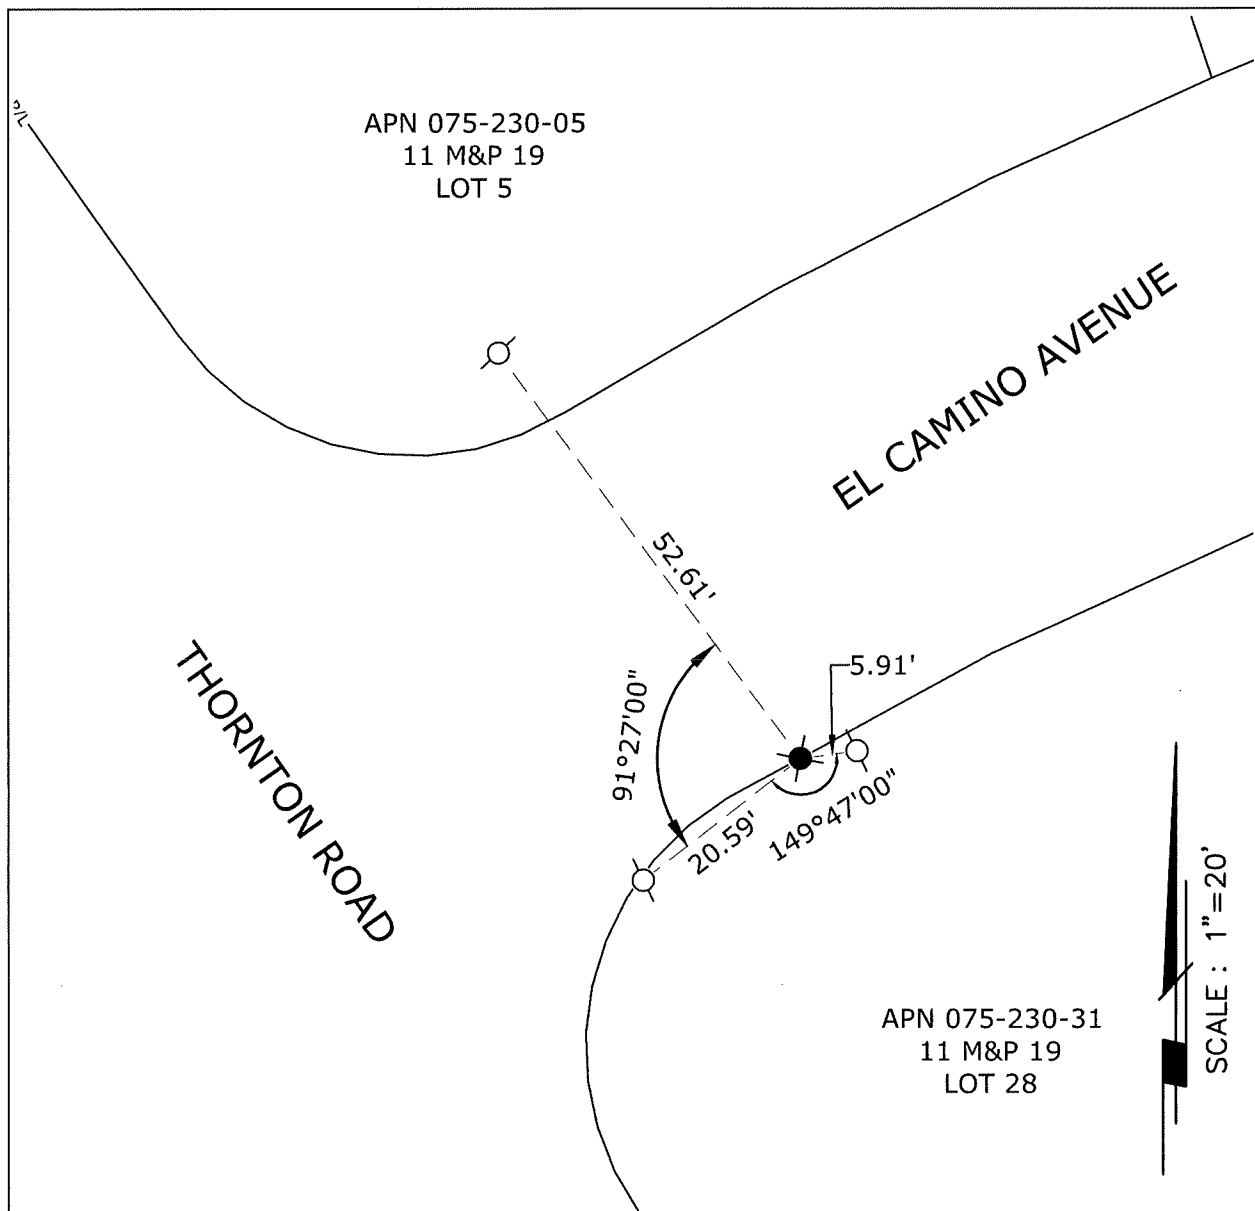

LEGEND:

FOUND 1" IRON PIPE, NO TAG



SET 5/8" REBAR W/ R.E.Y. CAP


S.J.C.R. SAN JOAQUIN COUNTY RECORDS

APN ASSESSOR'S PARCEL NUMBER

M&P MAPS & PLATS

REFERENCE:

11 M&P 19, S.J.C.R.

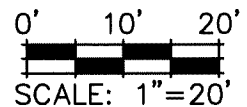

NOTE: THE PURPOSE OF THIS CORNER RECORD IS TO PERPETUATE THE POSITION(S) OF EXISTING MONUMENT(S). NO REPRESENTATION IS MADE TO ANY RELATIVE POSITION(S) OF SAID MONUMENT(S). ALL RIGHT OF WAY, PROPERTY LINES, CENTERLINES AND OTHERS ARE FOR GRAPHICAL REPRESENTATION ONLY.



905 Sutter St., Suite 200, Folsom, CA 95630
(916) 366-3040 Fax (916) 366-3303
R. E. Y. ENGINEERS, Inc.
Civil Engineers / Land Surveyors

CORNER RECORD EXHIBIT MAP

SCALE: 1" = 20'
JOB NO: 35318042
DATE: 8/21/2025
DWG: PALOMA AVE.