CORNER RECORD

CR-25-311 Agency Index **Document Number** STOCKTON County of City of SAN JOAQUIN Brief Legal Description LOTS 10, 12, 15 & 16 OF BLOCK 112, SOUTH OF MORMON CHANNEL **CORNER TYPE COORDINATES (Optional)** N. Government Corner Control Elevation U.S. Survey Foot Meander Property Units Metric Rancho Other **Horizontal Datum** Zone Epoch Date Date of Survey April 29, 2025 Vertical Datum Complies with Public Resources Code §§8801-8819 T.2S., R.8E., SEC 19 Complies with Public Resources Code §§8890-8902 PLS Act Ref.: × 8765(d) 8771 8773 Other: Left as found Established Rebuilt Pre-Construction Corner/ Monument: Found and tagged Reestablished X Referenced Post-Construction Narrative of corner identified and monument as found, set, reset, replaced, or removed: ✓ See sheet #2 for description(s): Referenced and reset monuments post-construction. THONESEN SURVEYOR'S STATEMENT This Corner Record was prepared by me or under my direction in conformance with the Professional Land Surveyors' Act on September 4, 2025 8656 P.L.S. or R.C.E. No. Signed **COUNTY SURVEYOR'S STATEMENT** Dc tober 7, 2025.


Haut P.L.S. OFR.C.E. No. 8657 This Corner Record was received and examined and filed

County Surveyor's Comment

Signed

Title



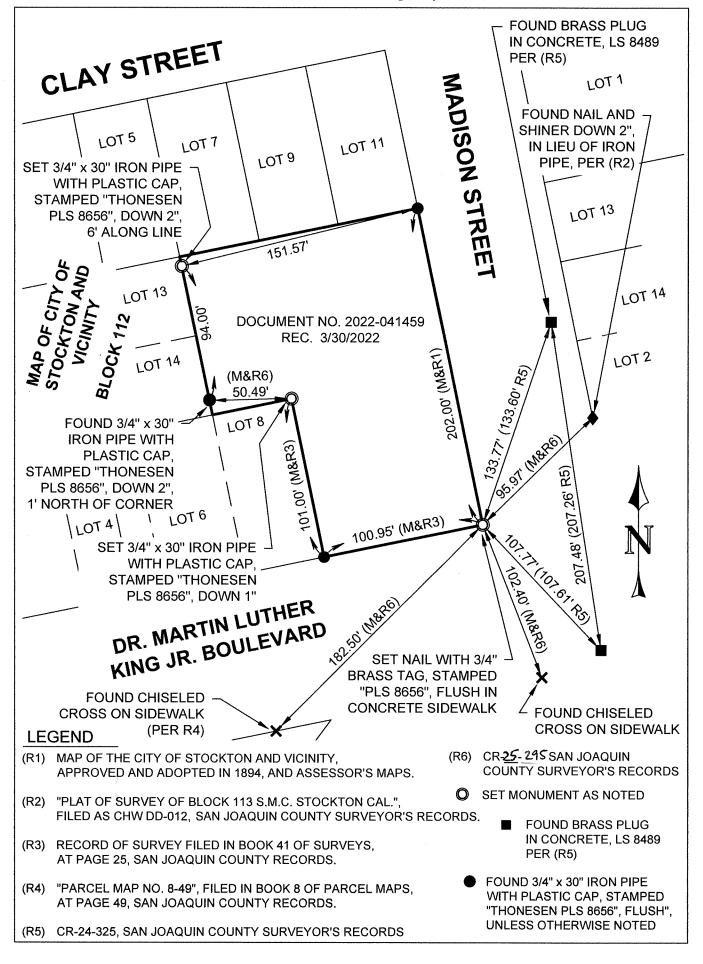

BPELSG-2016 Page 2 of 2