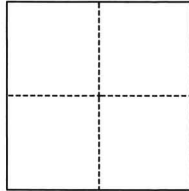


CORNER RECORD

Agency Index

CR-25-317

Document Number

City of Stockton County of San Joaquin, CaliforniaBrief Legal Description Lots 1185, 1186, 1187, 1188, 1189, M&P 25-66**CORNER TYPE****COORDINATES (Optional)**

- | | |
|--|--|
| <input type="checkbox"/> Government Corner | <input type="checkbox"/> Control |
| <input type="checkbox"/> Meander | <input checked="" type="checkbox"/> Property |
| <input type="checkbox"/> Rancho | <input type="checkbox"/> Other |

Date of Survey August 20, 2025

N. _____ E. _____

Elevation _____

Units ☐ Metric ☐ U.S. Survey Foot

Horizontal Datum _____

Zone _____ Epoch Date _____

Vertical Datum _____

☐ Complies with Public Resources Code §§8801-8819☐ Complies with Public Resources Code §§8890-8902

PLS Act Ref.:

☐ 8765(d)☒ 8771☐ 8773☐ Other:Corner/
Monument:☒ Left as found☐ Established☐ Rebuilt☐ Pre-Construction☐ Found and tagged☒ Reestablished☒ Referenced☒ Post-Construction

Narrative of corner identified and monument as found, set, reset, replaced, or removed:

☒ See sheet #2 for description(s):**SURVEYOR'S STATEMENT**

This Corner Record was prepared by me or under my direction in conformance with

the Professional Land Surveyors' Act on August 20, 2025

Signed

P.L.S. or R.C.E. No.

PLS 7889**COUNTY SURVEYOR'S STATEMENT**

This Corner Record was received

October 30, 2025

and examined and filed

November 4, 2025

Signed

P.L.S. or R.C.E. No.

8657

Title

County Surveyor

County Surveyor's Comment




LEGEND:

- M&P MAPS & PLATS, VOLUME AND PAGE,
SAN JOAQUIN COUNTY RECORDS
- FD FOUND
- FD CHISELED CROSS PER CORNER
RECORD 25-147,
SAN JOAQUIN COUNTY
SURVEYOR'S RECORDS
 - ⊙ FD 3/4" IRON PIN TAGGED "R.C.E."
15831" IN MONUMENT BOX PER
CORNER RECORD 25-147,
SAN JOAQUIN COUNTY
SURVEYOR'S RECORDS
 - SET 1.25" DIAMETER BRASS DISK
STAMPED "ELSON LS 7889"

DESCRIPTION:

THIS CORNER RECORD IS FOR THE PURPOSE OF MONUMENT PRESERVATION. REFERENCES WERE FOUND AND/OR SET FOR FOUND MONUMENTS AS NOTED ON DIAGRAM. NO BOUNDARY ANALYSIS WAS PERFORMED. THIS CORNER RECORD DOES NOT VERIFY THE MONUMENT(S) TO BE IN THE CORRECT POSITION.

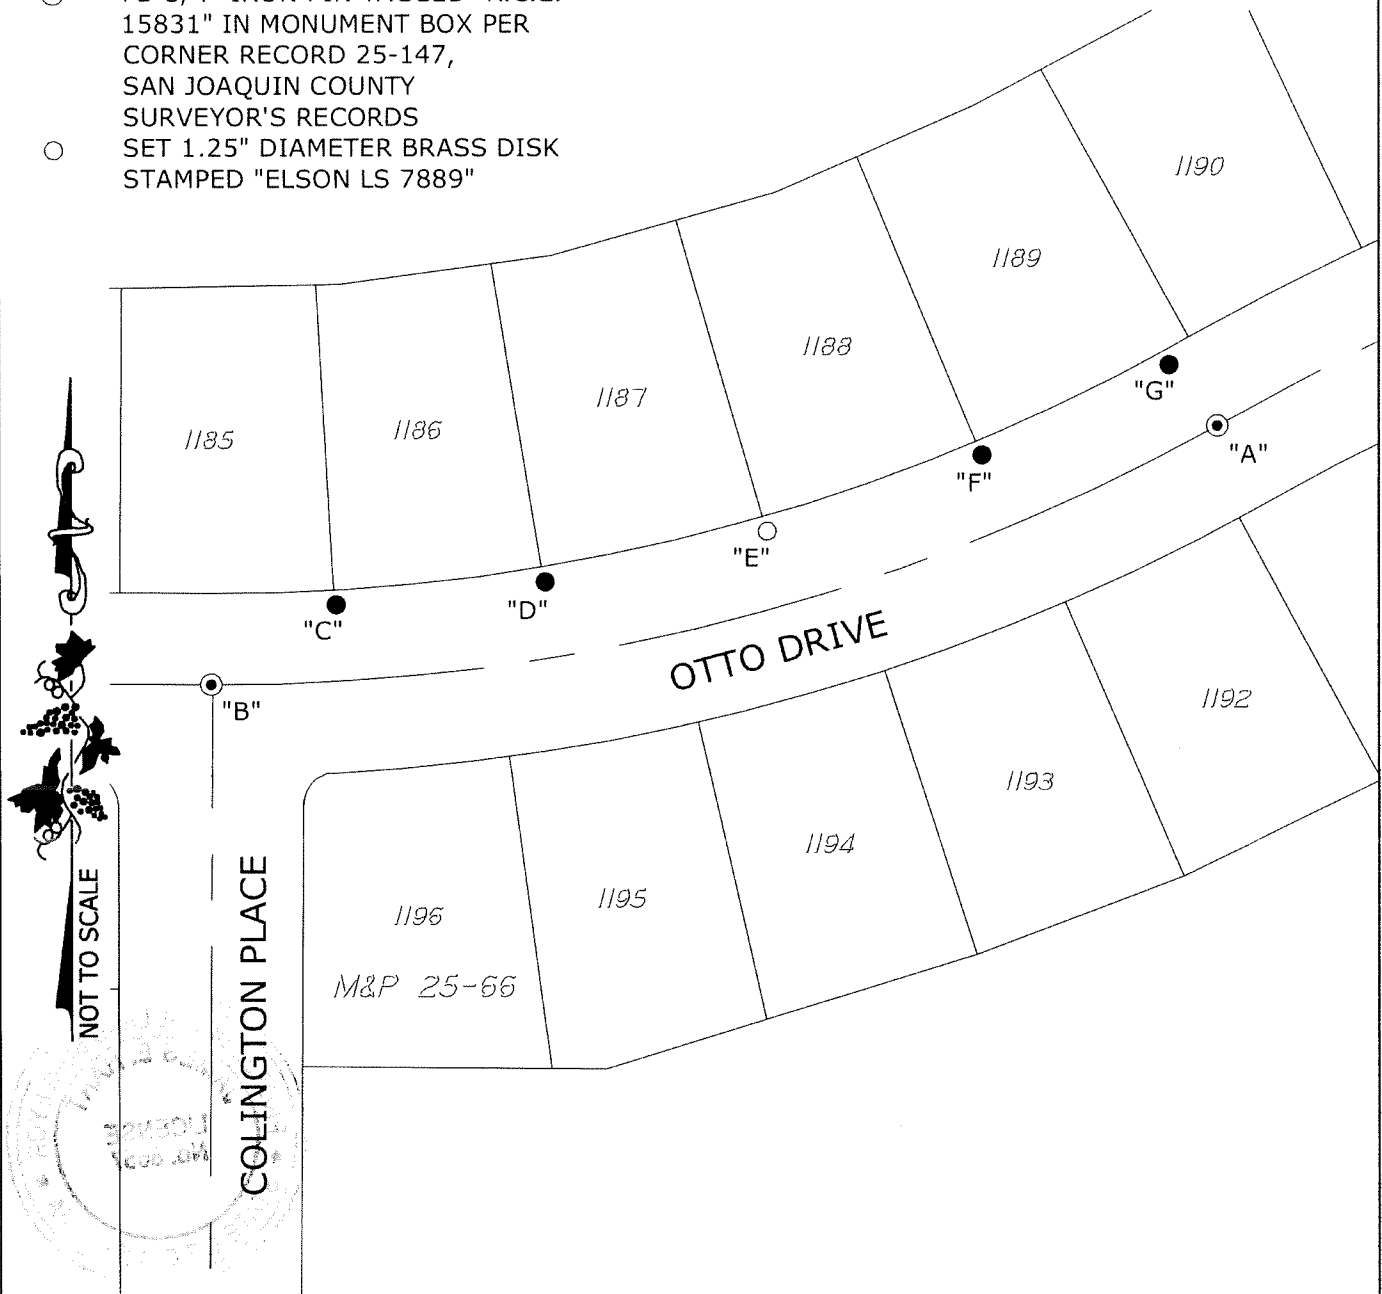

ANGLE AND DISTANCE TABLE			
BS-O-FS	ANGLE	BS DISTANCE	FS DISTANCE
A-C-B	158°51'53"	48.57'	295.01'
A-D-B	175°59'15"	114.63'	226.32'
A-E-B	177°49'10"	189.34'	151.48'
A-F-B	170°36'17"	263.92'	77.65'
A-G-B	109°52'58"	331.25'	25.48'