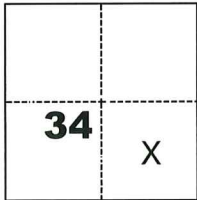


CORNER RECORD

Agency Index

CR-25-340

Document Number

City of UNINCORPORATED County of SAN JOAQUIN, CaliforniaBrief Legal Description S.E. COR. OF THE LOT SHOWN ON R.S. 41-99, S.J.C.R**CORNER TYPE****COORDINATES (Optional)**

- | | |
|--|-----------------------------------|
| <input type="checkbox"/> Government Corner | <input type="checkbox"/> Control |
| <input type="checkbox"/> Meander | <input type="checkbox"/> Property |
| <input type="checkbox"/> Rancho | <input type="checkbox"/> Other |

N. _____ E. _____

Elevation _____

Units ☐ Metric ☐ U.S. Survey Foot

Horizontal Datum _____

Zone _____ Epoch Date _____

Vertical Datum _____

☐ Complies with Public Resources Code §§8801-8819☐ Complies with Public Resources Code §§8890-8902Date of Survey September 9, 2025**C.M. Weber Grant**PLS Act Ref.: ☐ 8765(d) ☐ 8771 ☐ 8773 ☐ Other:

Corner/ Monument:	<input checked="" type="checkbox"/> Left as found	<input type="checkbox"/> Established	<input type="checkbox"/> Rebuilt	<input checked="" type="checkbox"/> Pre-Construction
	<input type="checkbox"/> Found and tagged	<input type="checkbox"/> Reestablished	<input checked="" type="checkbox"/> Referenced	<input type="checkbox"/> Post-Construction

Narrative of corner identified and monument as found, set, reset, replaced, or removed:

☒ See sheet #2 for description(s):


FOUND 3/4" REBAR W/ CAP STAMPED "LS 8080" NEAR THE SOUTHEAST CORNER OF THE LOT SHOWN ON R.S. 41-99, SAN JOAQUIN COUNTY RECORDS. See Map on page 2 of this corner record.

SURVEYOR'S STATEMENT

This Corner Record was prepared by me or under my direction in conformance with

the Professional Land Surveyors' Act on September 16, 2025Signed *Ronald E. Monsour* (P.L.S.) or R.C.E. No. 8474**COUNTY SURVEYOR'S STATEMENT**This Corner Record was received October 21, 2025and examined and filed October 28, 2025Signed *James E. Hart* P.L.S. or R.C.E. No. 8657Title County Surveyor**County Surveyor's Comment**

35610268

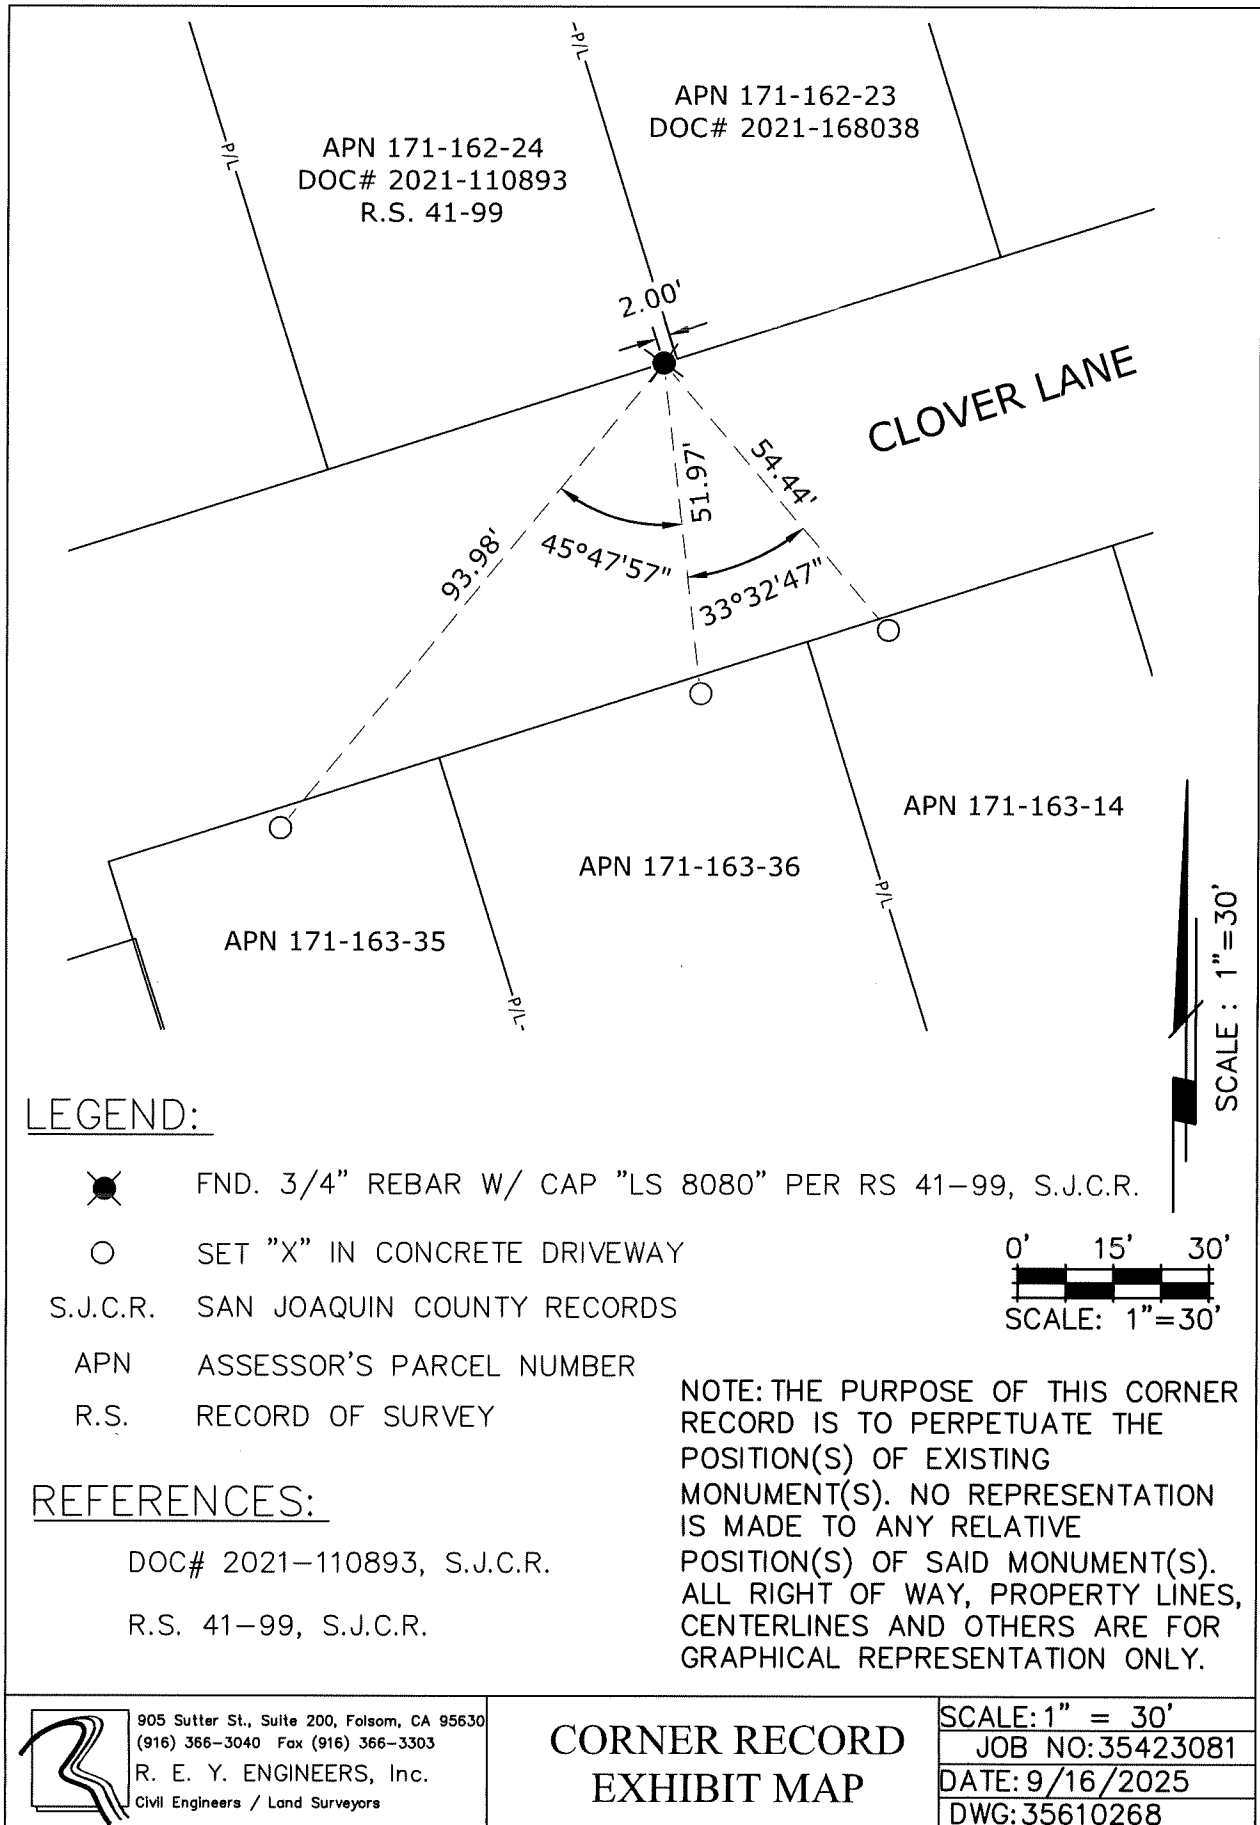

905 Sutter St., Suite 200, Folsom, CA 95630
 (916) 366-3040 Fax (916) 366-3303
 R. E. Y. ENGINEERS, Inc.
 Civil Engineers / Land Surveyors

CORNER RECORD EXHIBIT MAP

SCALE: 1" = 30'
 JOB NO: 35423081
 DATE: 9/16/2025
 DWG: 35610268