
## **CORNER RECORD**

Agency Index

Document Number

CR-25-342

			Document Number	
City of UNINCO	RPORATED COUNTY	AREA County of	SAN JOAQI	JIN, California
Brief Legal Descr	iptionSOUTHWI	EST QUARTER C	F SECTION 16, T.3 S.	, R.6 E., M.D.B.&M.
CORNER TYPE		COORDINATES (Optional)		
	Government C	orner Control	N Elevation	
	Meander Rancho		Units Metric  Horizontal Datum	✓ U.S. Survey Foot
	Date of Survey	— Мау 12, 2025	Zone Epoc	h Date
		Way 12, 2020	Complies with Public Re	esources Code §§8801-8819 esources Code §§8890-8902
PLS Act Ref.:	8765(d)	× 8771	8773	Other:
Corner/ Monument:	Left as found Found and tagged	Established Reestablished	Rebuilt Referenced	Pre-Construction  Post-Construction
This Corner Record w	<b>SURVEYOR'S S</b> vas prepared by me or under r	TATEMENT  ny direction in conforma  22, 2025	W SS	SED LAND SUPPLY OF CALIFORNIE
Signed	COUNTY SURVEYOR	P.L.S. or R.C.E. No.	<u>8137</u>	
This Corner Record wand examined and file Signed Title County Surveyor's	vas received <u>Octob</u> ed <u>November 10</u> ed <u>F. Haut</u> uty Scrueyor	er 16, 2025		LICENSE No. 8657

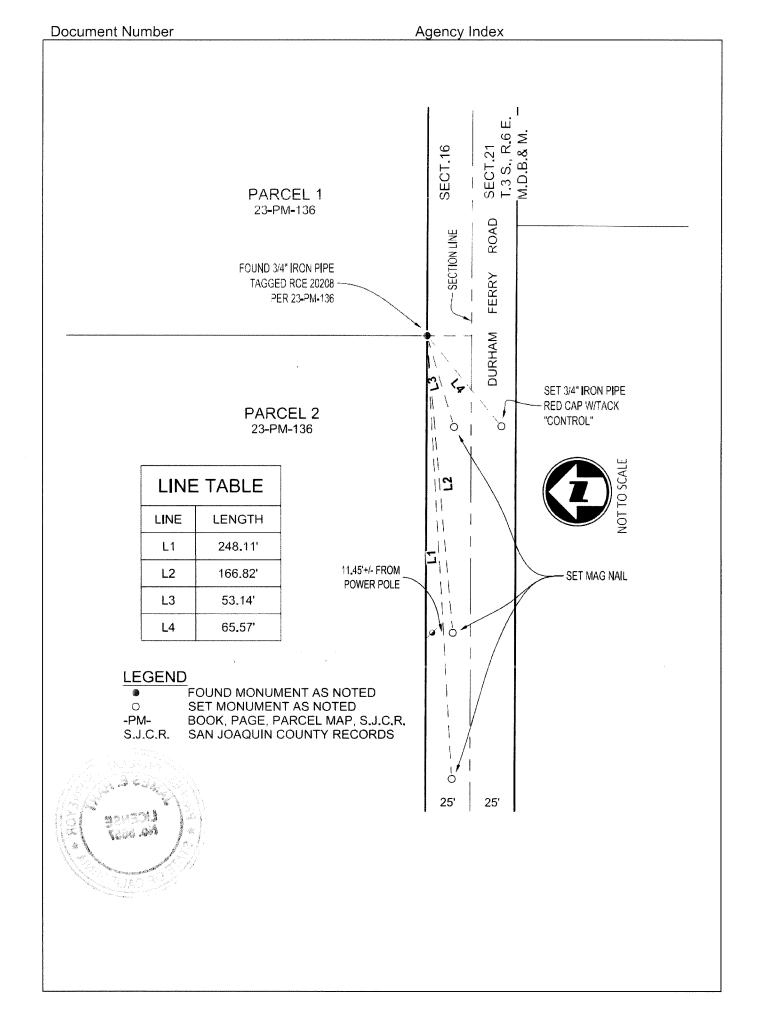

BPELSG-2016 Page 2 of 2