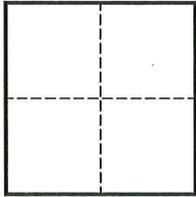


CORNER RECORD

Agency Index CR-25-388

Document Number _____

City of _____ County of SAN JOAQUIN, CaliforniaBrief Legal Description AT THE INTERSECTION OF LOWELL AVENUE AND FAIRMONT AVENUE**CORNER TYPE****COORDINATES (Optional)**

- Government Corner Control
 Meander Property
 Rancho Other

N. _____ E. _____

Elevation _____

Units Metric U.S. Survey Foot

Horizontal Datum _____

Zone _____ Epoch Date _____

Vertical Datum _____

 Complies with Public Resources Code §§8801-8819 Complies with Public Resources Code §§8890-8902PLS Act Ref.: 8765(d) 8771 8773 Other:Corner/ Left as found Established Rebuilt Pre-ConstructionMonument: Found and tagged Reestablished Referenced Post-Construction

Narrative of corner identified and monument as found, set, reset, replaced, or removed:



 See sheet #2 for description(s):

FOUND 3/4" IRON ROD NO PUNCH IN MONUMENT WELL, AS SHOWN ON CR-16-409, SAN JOAQUIN COUNTY SURVEYOR'S RECORDS.



MONUMENT WAS FOUND AS "UNDISTURBED" FOLLOWING THE CONSTRUCTION OF A WATER LINE PROJECT DONE BY CALIFORNIA WATER SERVICE.

SURVEYOR'S STATEMENT

This Corner Record was prepared by me or under my direction in conformance with

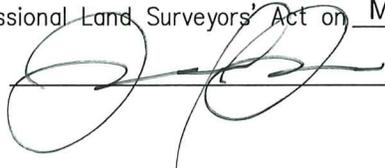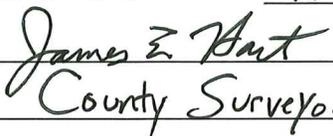the Professional Land Surveyors' Act on MAY 12, 2025Signed  P.L.S. or R.C.E. No. 9592**COUNTY SURVEYOR'S STATEMENT**This Corner Record was received November 12, 2025and examined and filed November 20, 2025Signed  P.L.S. or R.C.E. No. 8657Title County Surveyor**County Surveyor's Comment**

Empty dashed box for County Surveyor's Comment.

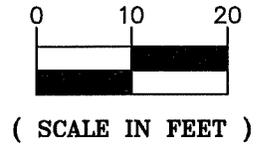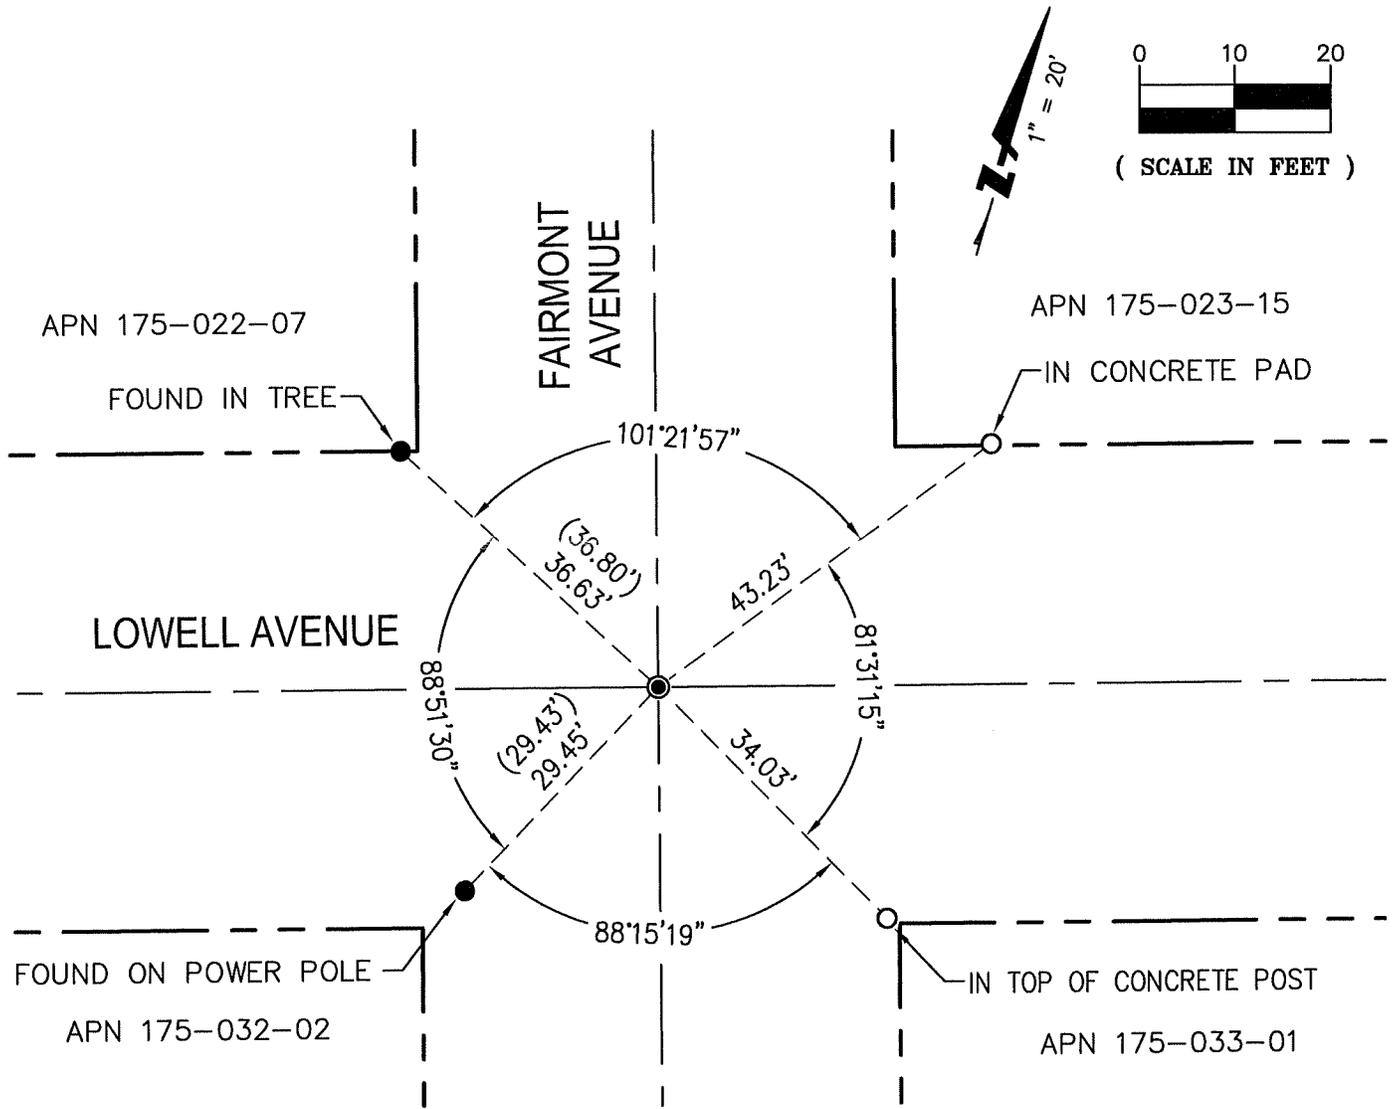

LEGEND

- FOUND 3/4" IRON ROD NO PUNCH IN MONUMENT WELL, AS SHOWN ON CR-16-409, SAN JOAQUIN COUNTY SURVEYOR'S RECORDS.
- FOUND MAG NAIL AND WASHER STAMPED BKF CONTROL, AS NOTED, PER CR-24-340, SAN JOAQUIN COUNTY SURVEYOR'S RECORDS.
- FOUND NAIL WITH BRASS TAGGED SJCO, PER CR-16-409
- () RECORD INFORMATION AS SHOWN ON CR-16-409, SAN JOAQUIN COUNTY SURVEYOR'S RECORDS
- CR CORNER RECORD
- SJCO SAN JOAQUIN COUNTY



1730 N. FIRST STREET
 SUITE 600
 SAN JOSE, CA 95112
 (408) 467-9100
 www.bkf.com

SUBJECT POST-CONSTRUCTION CORNER RECORD
AT LOWELL AVE AND FAIRMONT AVE

JOB NO. 20191483-358 MON PRESERVATION
 BY GA APPR. RDV DATE 05-12-2025

I:\2019\1483-358 MON PRESERVATION\JOB CR 202 LOWELL AVE\JOB CR 202 LOWELL AVE\JOB CR 202 LOWELL AVE\POSTING