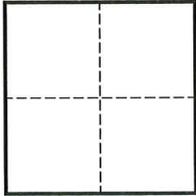


CORNER RECORD

Agency Index CR-25-392

Document Number _____

City of _____ County of SAN JOAQUIN, CaliforniaBrief Legal Description MONUMENT AT THE INTERSECTION OF OPHIR STREET AND EIGHTH STREET.**CORNER TYPE****COORDINATES (Optional)**

- Government Corner Control
 Meander Property
 Rancho Other

N. _____ E. _____

Elevation _____

Units Metric U.S. Survey Foot

Horizontal Datum _____

Zone _____ Epoch Date _____

Vertical Datum _____

 Complies with Public Resources Code §§8801-8819 Complies with Public Resources Code §§8890-8902PLS Act Ref.: 8765(d) 8771 8773 Other:Corner/Monument: Left as found Established Rebuilt Pre-Construction Found and tagged Reestablished Referenced Post-Construction

Narrative of corner identified and monument as found, set, reset, replaced, or removed:


 See sheet #2 for description(s):

FOUND 1/2" REBAR WITH PUNCH IN MONUMENT WELL AT THE WESTERLY INTERSECTION OF EIGHTH STREET AND OPHIR STREET, PER CR-24-466, SAN JOAQUIN COUNTY SURVEYOR'S RECORDS.


MONUMENT WAS FOUND AS "UNDISTURBED" FOLLOWING THE CONSTRUCTION OF A WATER LINE REPLACEMENT PROJECT DONE BY WEST VALLEY CONSTRUCTION COMPANY.

SURVEYOR'S STATEMENT

This Corner Record was prepared by me or under my direction in conformance with

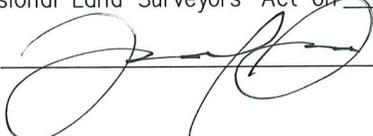the Professional Land Surveyors' Act on MAY 12, 2025Signed  P.L.S. or R.C.E. No. 9592**COUNTY SURVEYOR'S STATEMENT**This Corner Record was received November 12, 2025and examined and filed November 20, 2025Signed James E. Hart P.L.S. or R.C.E. No. 8657Title County Surveyor**County Surveyor's Comment**

Empty dashed box for County Surveyor's Comment.

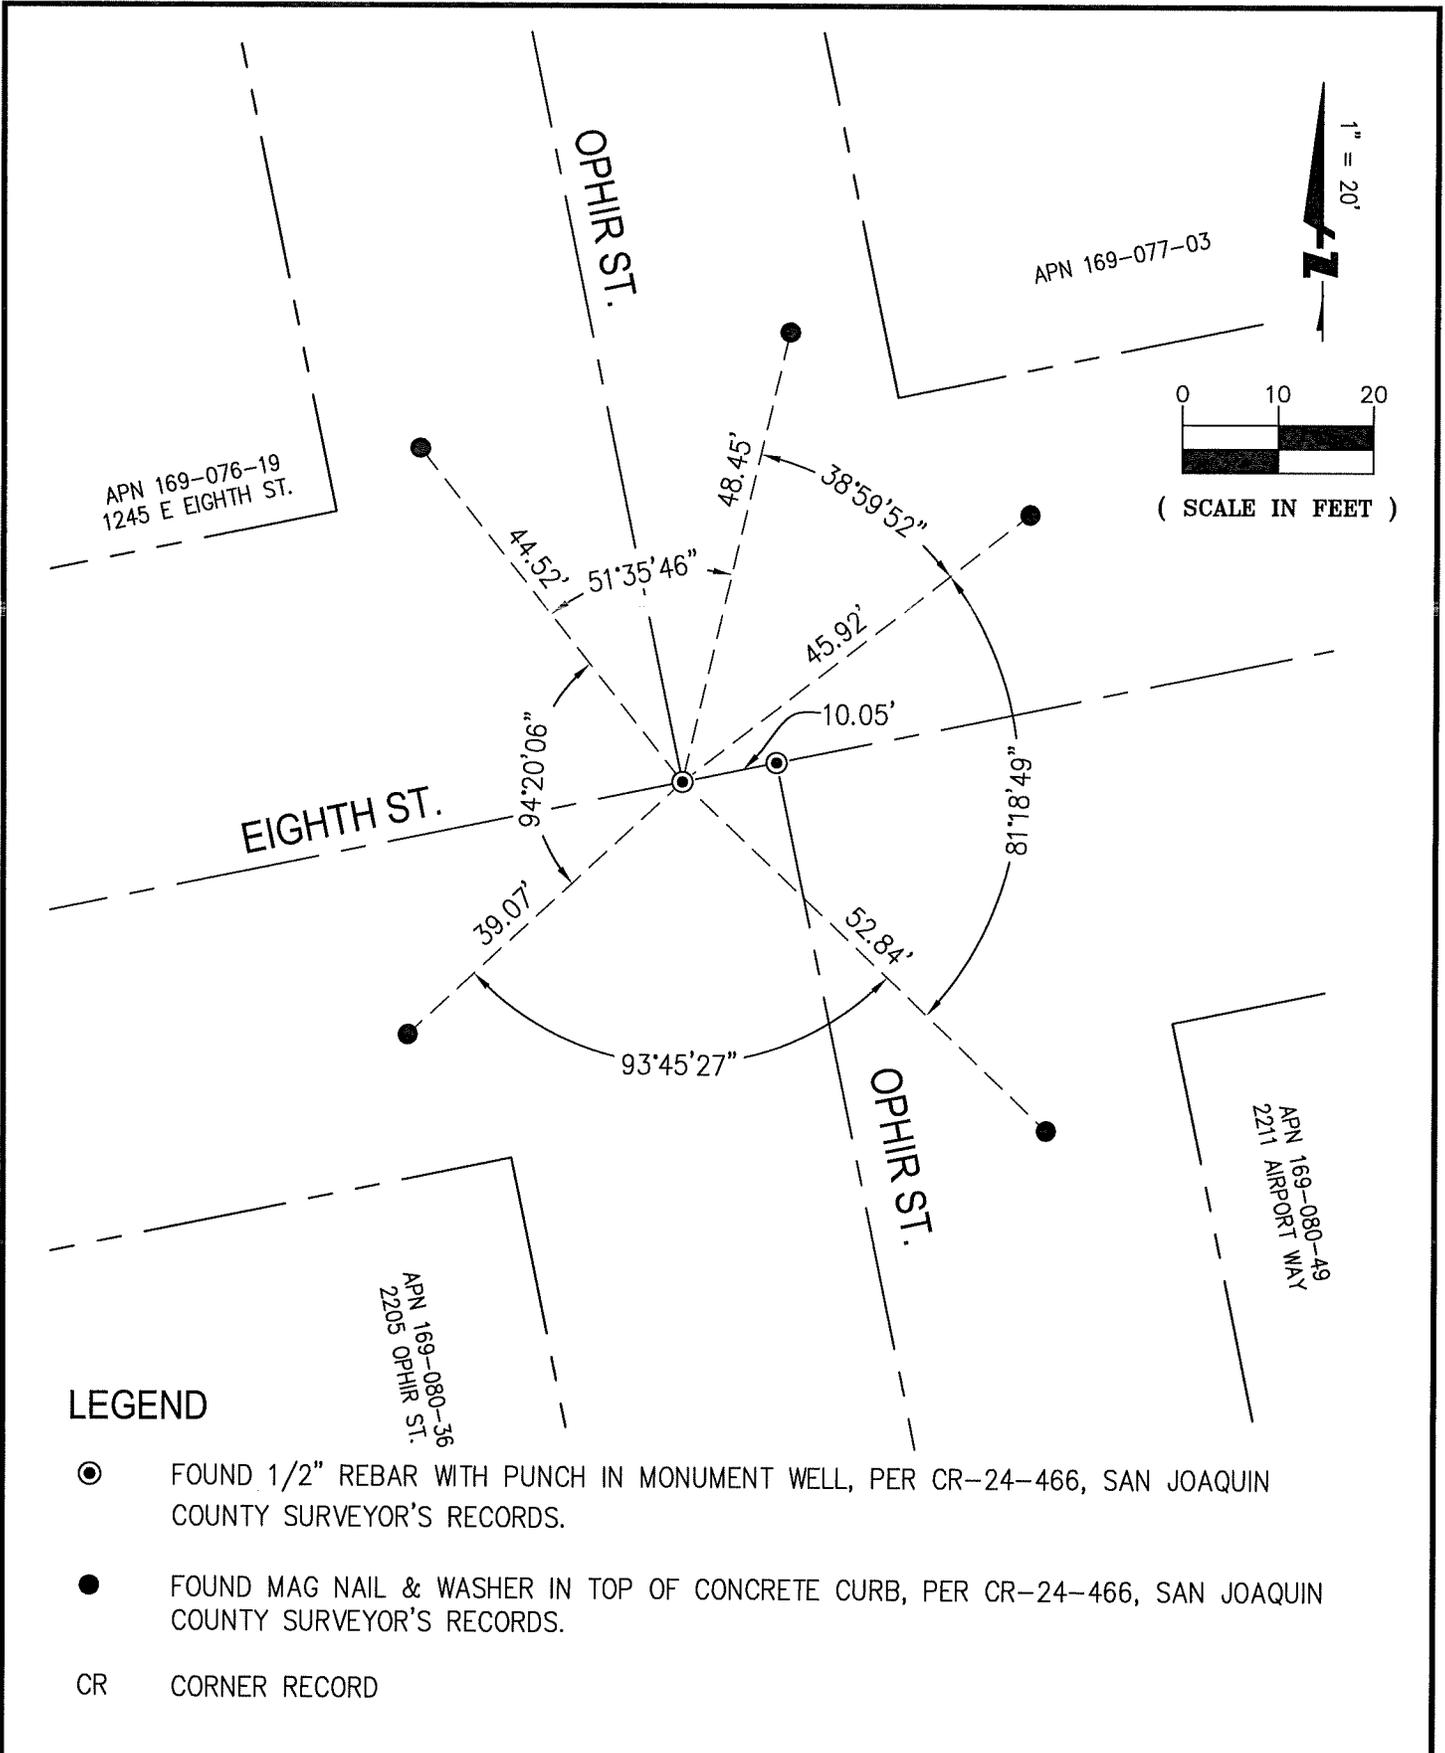

LEGEND

- FOUND 1/2" REBAR WITH PUNCH IN MONUMENT WELL, PER CR-24-466, SAN JOAQUIN COUNTY SURVEYOR'S RECORDS.
- FOUND MAG NAIL & WASHER IN TOP OF CONCRETE CURB, PER CR-24-466, SAN JOAQUIN COUNTY SURVEYOR'S RECORDS.
- CR CORNER RECORD

K:\2019\191483_MON_PRES\SURV\DWG\354_STK-210_ORPHIR_POSTING

BKF
 1730 N. FIRST STREET
 SUITE 600
 SAN JOSE, CA 95112
 (408) 467-9100
 www.bkf.com

SUBJECT POST-CONSTRUCTION CORNER RECORD AT
INTERSECTION OF OPHIR STREET AND 8TH STREET

JOB NO. 20191483 - MON PRESERVATION
 BY AV APPR. RV DATE 05-12-2025