

CORNER RECORD

Agency Index CR-25-393


Document Number _____

City of _____ County of SAN JOAQUIN, California

Brief Legal Description MONUMENT ALONG THE CL OF EIGHTH ST, SWLY OF THE CL OF AIRPORT WAY.

CORNER TYPE

COORDINATES (Optional)

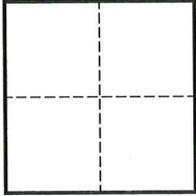

- Government Corner
- Meander
- Rancho
- Control
- Property
- Other

N. _____ E. _____

Elevation _____

Units Metric U.S. Survey Foot

Horizontal Datum _____

Zone _____ Epoch Date _____

Vertical Datum _____

Complies with Public Resources Code §§8801-8819

Complies with Public Resources Code §§8890-8902

PLS Act Ref.: 8765(d) 8771 8773 Other:

Corner/Monument: Left as found Established Rebuilt Pre-Construction

Found and tagged Reestablished Referenced Post-Construction

Narrative of corner identified and monument as found, set, reset, replaced, or removed:

See sheet #2 for description(s):

FOUND 2-1/2" BRASS DISC, STAMPED "CITY OF STOCKTON SURVEY MONUMENT 5S-19" IN MONUMENT WELL, ALONG THE CENTERLINE OF EIGHTH STREET, SOUTHWESTERLY OF THE CL OF AIRPORT WAY, PER RECORD OF SURVEY 35-5.

MONUMENT WAS FOUND AS "UNDISTURBED" FOLLOWING THE CONSTRUCTION OF A WATER LINE REPLACEMENT PROJECT DONE BY WEST VALLEY CONSTRUCTION COMPANY.

SURVEYOR'S STATEMENT

This Corner Record was prepared by me or under my direction in conformance with

the Professional Land Surveyors' Act on MAY 12, 2025

Signed [Signature] P.L.S. or R.C.E. No. 9592



COUNTY SURVEYOR'S STATEMENT

This Corner Record was received November 12, 2025

and examined and filed November 20, 2025


Signed James E. Hart P.L.S. or R.C.E. No. 8657

Title County Surveyor




County Surveyor's Comment

[Empty dashed box for County Surveyor's Comment]

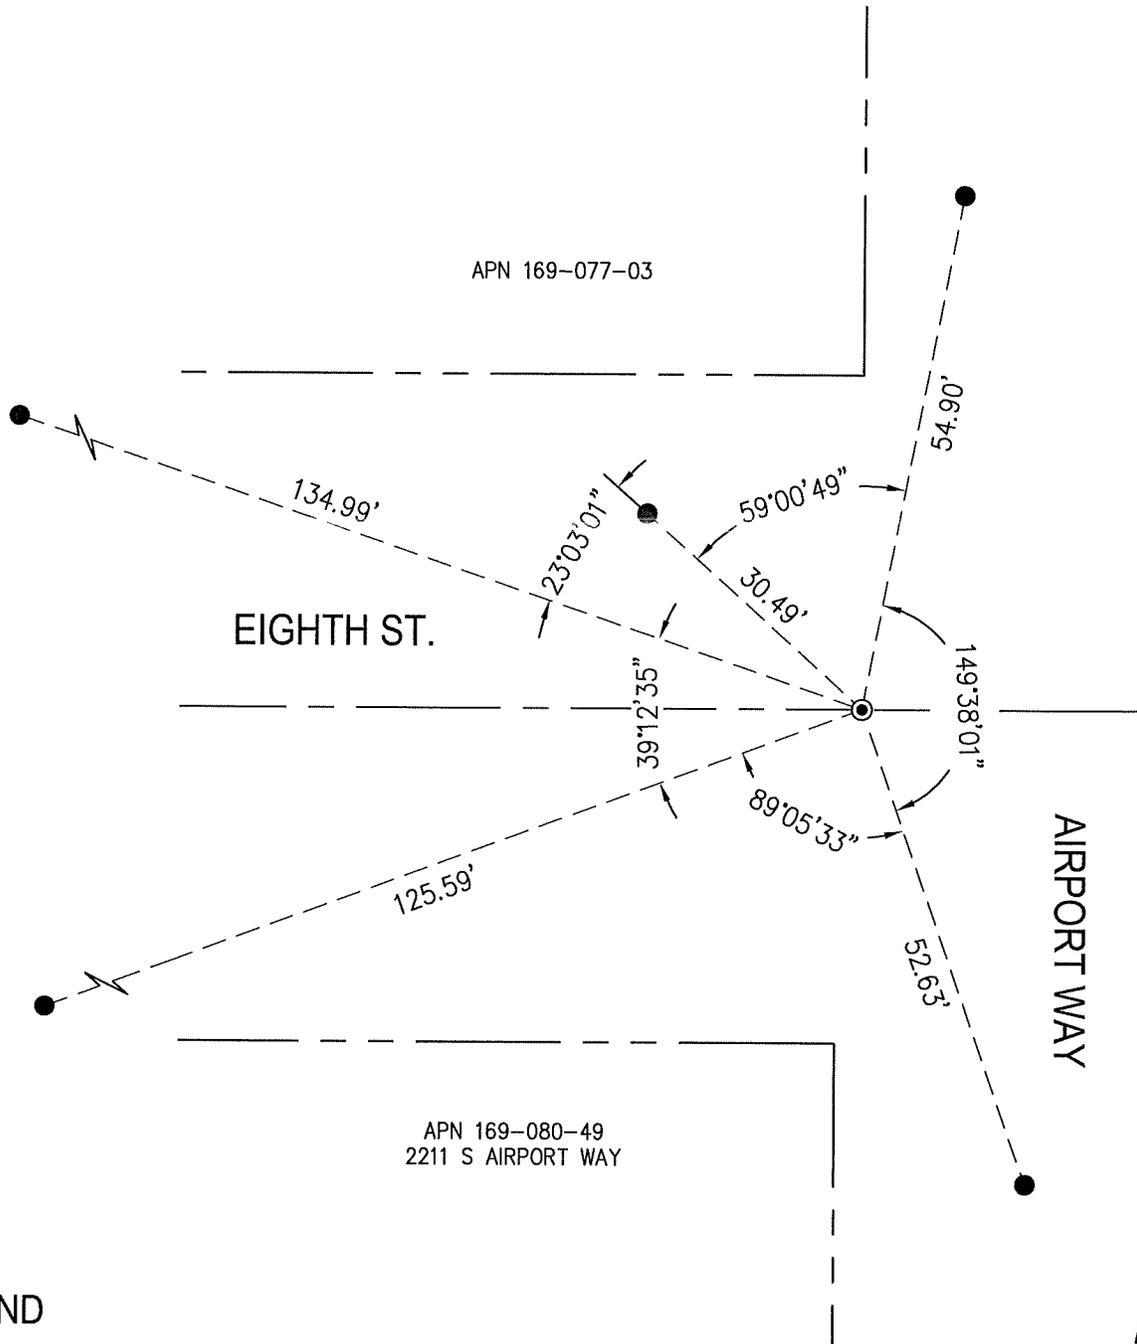

LEGEND

- ⊙ FOUND 2 1/2" BRASS DISK, STAMPED "CITY OF STOCKTON SURVEY MONUMENT 5S-19" IN MONUMENT WELL, PER RECORD OF SURVEY 35-5.
- FOUND MAG NAIL & WASHER IN TOP OF CONCRETE CURB, PER CR-24-467, SAN JOAQUIN COUNTY SURVEYOR'S RECORDS.
- CR CORNER RECORD

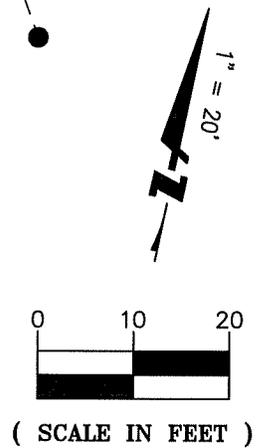

K:\2019\191483_MON_PRES\SUR\DWG\354_STK_CR_STK-210_ORPHR_POST.DWG



1730 N. FIRST STREET
SUITE 600
SAN JOSE, CA 95112
(408) 467-9100
www.bkf.com

SUBJECT POST-CONSTRUCTION CORNER RECORD ALONG CENTERLINE OF EIGHTH STREET, SWLY OF AIRPORT

JOB NO. 20191483 - MON PRESERVATION
BY AV APPR. RV DATE 05-12-2025