

CORNER RECORD

Agency Index CR-25-398
 Document Number _____

City of STOCKTON County of SAN JOAQUIN, California
 Brief Legal Description FOUND MONUMENTS PER BOOK 14 OF MAPS AND PLATS, PAGE 53 AND BOOK 16 OF MAPS AND PLATS, PAGE 36, SAN JOAQUIN COUNTY RECORDS.



T2N/R6E

CORNER TYPE

- Government Corner Control
 Meander Property
 Rancho Other

Date of Survey FEBRUARY 17, 2025

COORDINATES (Optional)

- N. _____ E. _____
 Elevation _____
 Units Metric U.S. Survey Foot
 Horizontal Datum _____
 Zone _____ Epoch Date _____
 Vertical Datum _____
 Complies with Public Resources Code §§8801-8819
 Complies with Public Resources Code §§8890-8902

- PLS Act Ref.: 8765(d) 8771 8773 Other:
 Corner/
 Monument: Left as found Established Rebuilt Pre-Construction
 Found and tagged Reestablished Referenced Post-Construction

Narrative of corner identified and monument as found, set, reset, replaced, or removed:
 See sheet #2 for description(s):

THE FOUND MONUMENT(S) SHOWN ON THIS CORNER RECORD WERE FOUND IN THE APPROXIMATE RECORD LOCATION OF THE CORNER(S) ON 14-MP-53 AND 16-MP-36, SAN JOAQUIN COUNTY RECORDS. I DID NOT VERIFY THE IDENTITY AND VALIDITY OF THE MONUMENT FOUND AS ACTUALLY MARKING THE PROPERTY CORNER.

SURVEYOR'S STATEMENT

This Corner Record was prepared by me or under my direction in conformance with
 the Professional Land Surveyors' Act on FEBRUARY 25, 2025
 Signed [Signature] P.L.S. or R.C.E. No. 8489



COUNTY SURVEYOR'S STATEMENT


This Corner Record was received November 21, 2025
 and examined and filed November 24, 2025
 Signed [Signature] P.L.S. or R.C.E. No. 8657
 Title County Surveyor



County Surveyor's Comment

Document Number

Agency Index

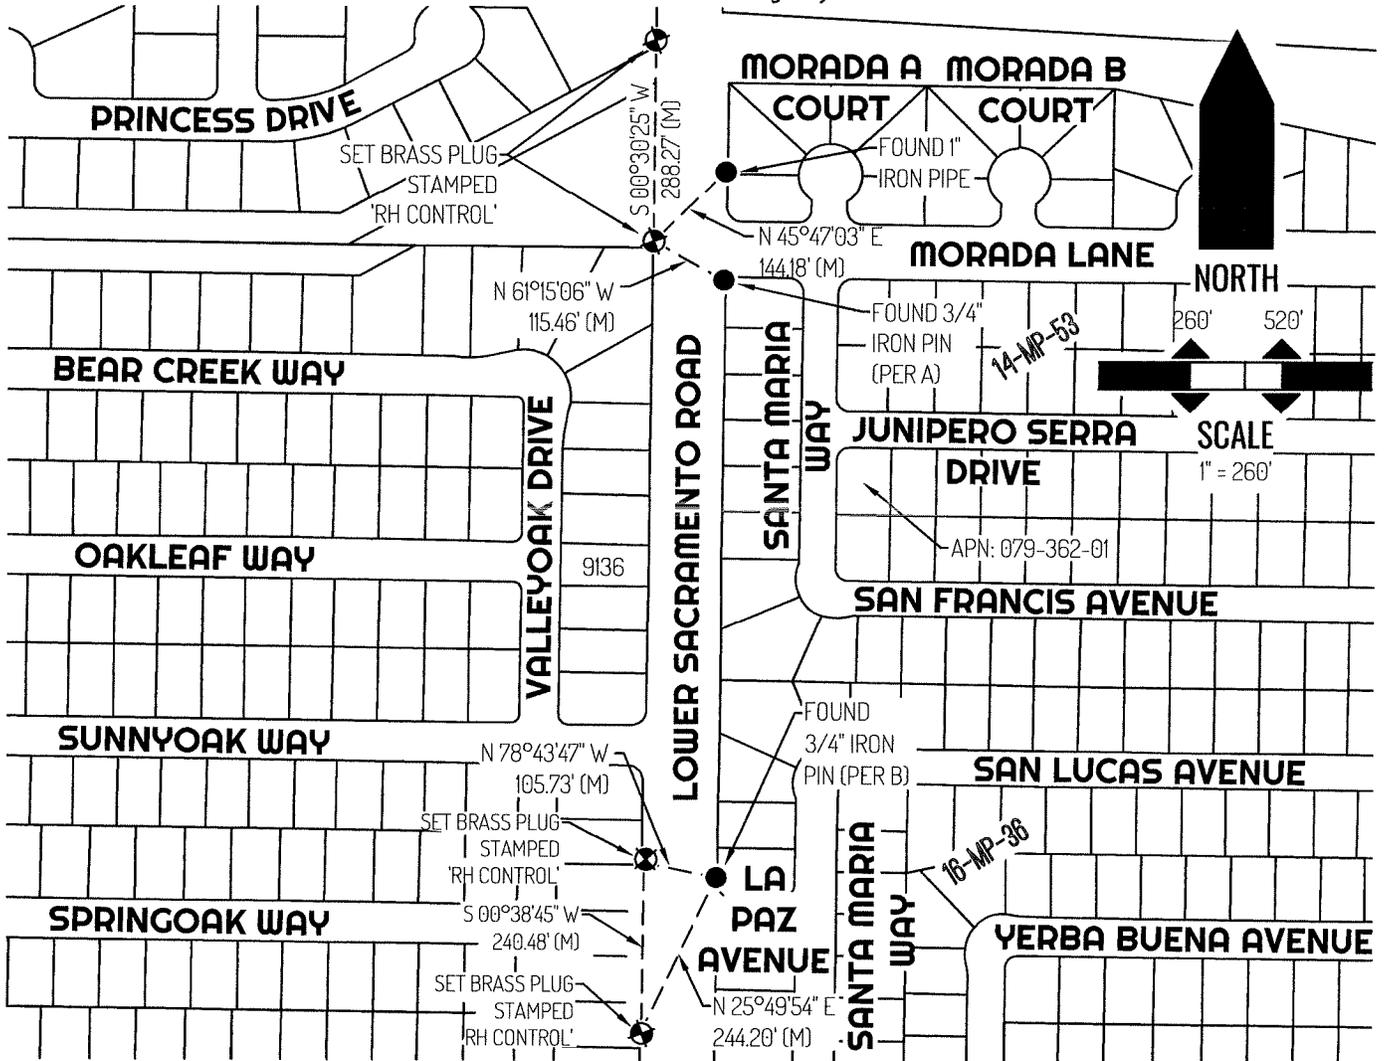

LEGEND

●	FOUND MONUMENT AS NOTED
⊕	SET CONTROL POINT
9136	REFERENCE STREET ADDRESS
S.J.C.R.	SAN JOAQUIN COUNTY RECORDS
APN	TAX ASSESSOR PARCEL NUMBER
(M)	MEASURED
---	TIE LINE
—	LOT LINE

SURVEYOR NOTE

THIS CORNER RECORD IS BEING FILED TO FULFILL THE PRE-CONSTRUCTION MONUMENT PRESERVATION REQUIREMENTS OF SECTION 8771 OF THE CALIFORNIA BUSINESS AND PROFESSIONS CODE. IT IS NOT THE RESULT OF A FULLY RESOLVED BOUNDARY SURVEY FOR ANY PARCEL OF REAL PROPERTY.

REFERENCE

- (A) BOOK 14 OF MAPS AND PLATS, AT PAGE 53, SAN JOAQUIN COUNTY RECORDS.
- (B) BOOK 16 OF MAPS AND PLATS, AT PAGE 36, SAN JOAQUIN COUNTY RECORDS.