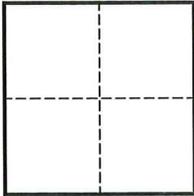


CORNER RECORD

Agency Index CR-25-401

Document Number _____

City of STOCKTON County of SAN JOAQUIN CaliforniaBrief Legal Description CUT 'X' ALONG THE LOT LINE PRODUCTION BETWEEN 2321 & 2315 BONNIEBROOK DR**CORNER TYPE****COORDINATES (Optional)**

- Government Corner Control
 Meander Property
 Rancho Other

N. _____ E. _____

Elevation _____

Units Metric U.S. Survey Foot

Horizontal Datum _____

Zone _____ Epoch Date _____

Vertical Datum _____

Date of Survey MARCH 12, 2025 Complies with Public Resources Code §§8801-8819 Complies with Public Resources Code §§8890-8902PLS Act Ref.: 8765(d) 8771 8773 Other:

Corner/
Monument: Left as found Established Rebuilt Pre-Construction
 Found and tagged Reestablished Referenced Post-Construction

Narrative of corner identified and monument as found, set, reset, replaced, or removed:

 See sheet #2 for description(s):


FOUND CUT 'X' IN CONCRETE SIDEWALK, LOCATED ALONG THE PRODUCTION OF THE LOT LINE BETWEEN 2321 & 2315 BONNIEBROOK DR, PER CR-25-046, SAN JOAQUIN COUNTY SURVEYOR'S RECORDS.

THE FOUND POINT WAS FOUND AS "UNDISTURBED", FOLLOWING THE CONSTRUCTION OF A WATERLINE REPLACEMENT PROJECT DONE BY WEST VALLEY CONSTRUCTION COMPANY.


SURVEYOR'S STATEMENT

This Corner Record was prepared by me or under my direction in conformance with

the Professional Land Surveyors' Act on MAY 12, 2025Signed  P.L.S. or R.C.E. No. 9592**COUNTY SURVEYOR'S STATEMENT**This Corner Record was received November 12, 2025and examined and filed November 24, 2025Signed James E. Hart P.L.S. or R.C.E. No. 8657Title County Surveyor**County Surveyor's Comment**

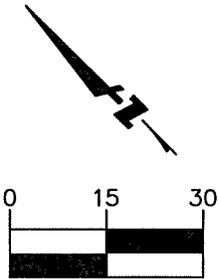

(SCALE 1" = 30')

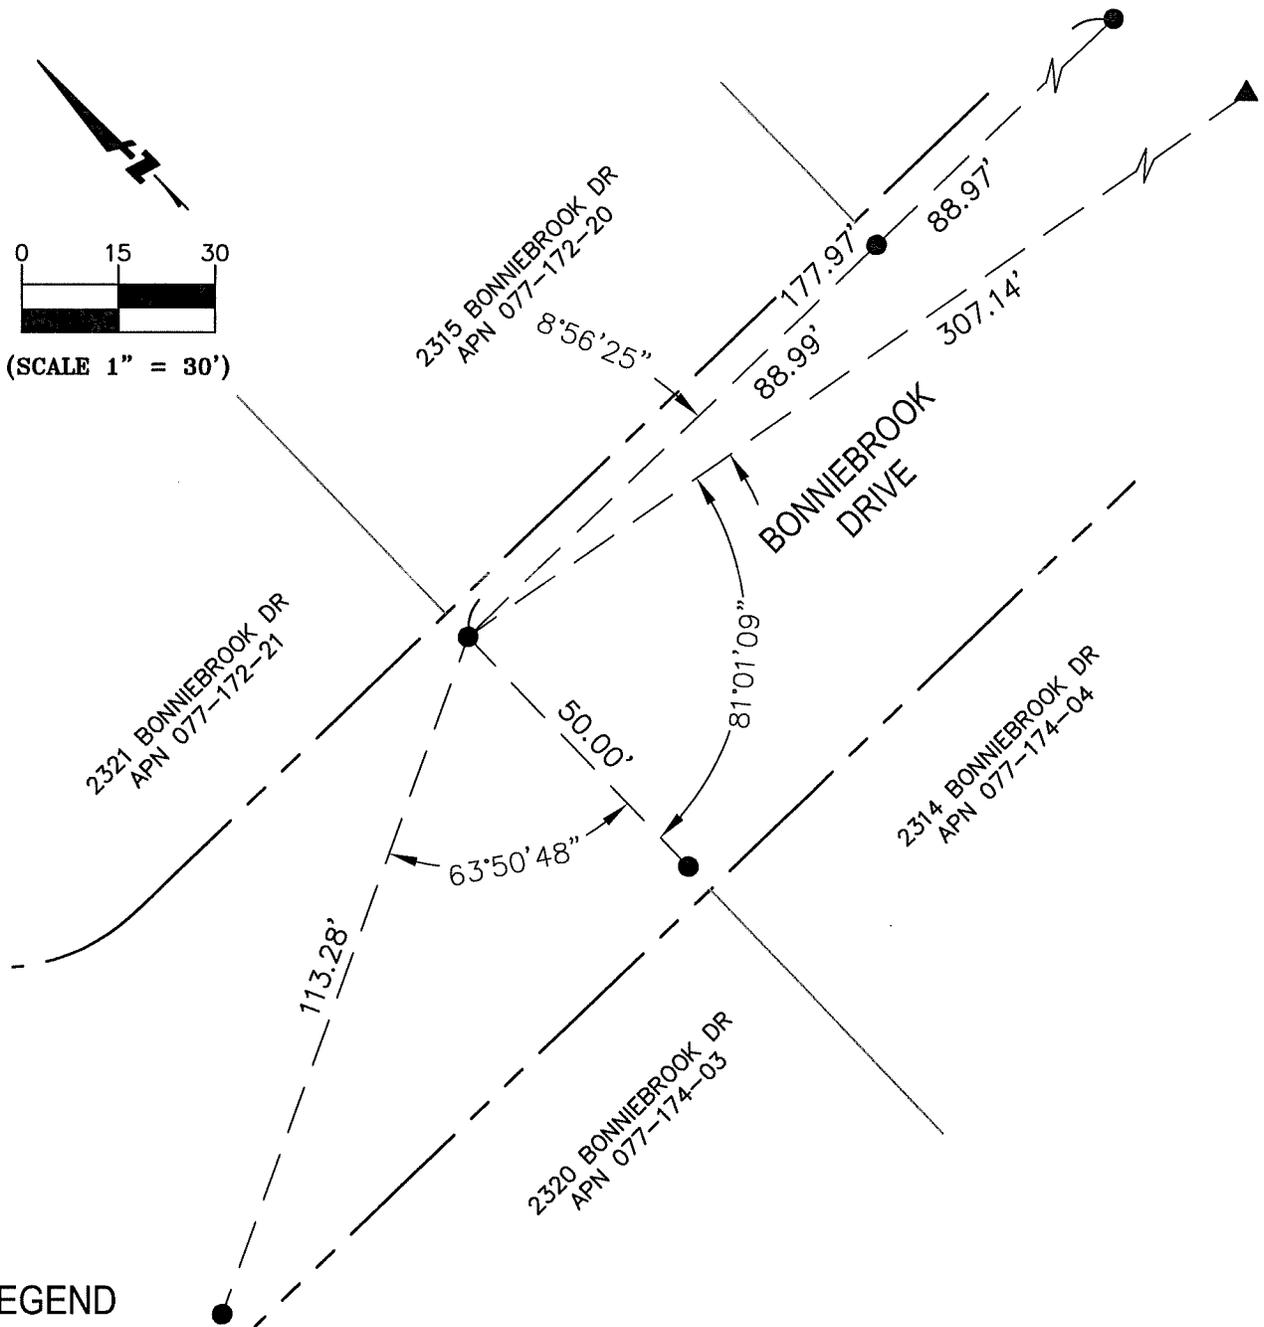

LEGEND

- FOUND CUT 'X' IN CONCRETE SIDEWALK, PER CR-25-046, SAN JOAQUIN COUNTY SURVEYOR'S RECORDS
- ▲ FOUND MAG AND WASHER STAMPED "PLS 6868" AT BACK OF ROLLED CURB, PER CR-25-046, SAN JOAQUIN COUNTY SURVEYOR'S RECORDS

APN ASSESSOR'S PARCEL NUMBER

CR CORNER RECORD



1730 N. FIRST STREET
 SUITE 600
 SAN JOSE, CA 95112
 408-467-9100
 www.bkf.com

Subject POST-CONSTRUCTION CORNER RECORD

AT 2321 & 2315 BONNIEBROOK DRIVE

Job No. 20191483-375 - MON PRESERVATION

By GA Date 05-12-2024 Chkd. RV

SHEET 2 OF 2