

# CORNER RECORD

Agency Index CR-25-403


Document Number \_\_\_\_\_

City of STOCKTON County of SAN JOAQUIN California

Brief Legal Description CUT 'X' ALONG THE LOT LINE PRODUCTION BETWEEN 2314 & 2320 BONNIEBROOK DR

### CORNER TYPE

### COORDINATES (Optional)

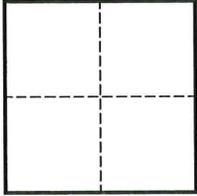

- Government Corner
- Meander
- Rancho
- Control
- Property
- Other

N. \_\_\_\_\_ E. \_\_\_\_\_

Elevation \_\_\_\_\_

Units  Metric  U.S. Survey Foot

Horizontal Datum \_\_\_\_\_

Zone \_\_\_\_\_ Epoch Date \_\_\_\_\_

Vertical Datum \_\_\_\_\_

Date of Survey MARCH 12, 2025

Complies with Public Resources Code §§8801-8819

Complies with Public Resources Code §§8890-8902

PLS Act Ref.:  8765(d)  8771  8773  Other:

Corner/Monument:  Left as found  Established  Rebuilt  Pre-Construction

Found and tagged  Reestablished  Referenced  Post-Construction

Narrative of corner identified and monument as found, set, reset, replaced, or removed:

See sheet #2 for description(s):

FOUND CUT 'X' IN CONCRETE SIDEWALK, LOCATED ALONG THE PRODUCTION OF THE LOT LINE BETWEEN 2320 & 2314 BONNIEBROOK DR, PER CR -25-044, SAN JOAQUIN COUNTY SURVEYOR'S RECORDS.

THE POINT WAS FOUND AS "UNDISTURBED", FOLLOWING THE CONSTRUCTION OF A WATERLINE REPLACEMENT PROJECT DONE BY WEST VALLEY CONSTRUCTION COMPANY.

### SURVEYOR'S STATEMENT

This Corner Record was prepared by me or under my direction in conformance with

the Professional Land Surveyors' Act on MAY 12, 2025

Signed [Signature] P.L.S. or R.C.E. No. 9592



### COUNTY SURVEYOR'S STATEMENT

This Corner Record was received November 12, 2025

and examined and filed November 24, 2025



Signed James E. Hart P.L.S. or R.C.E. No. 8657

Title County Surveyor



### County Surveyor's Comment

[Empty dashed box for County Surveyor's Comment]

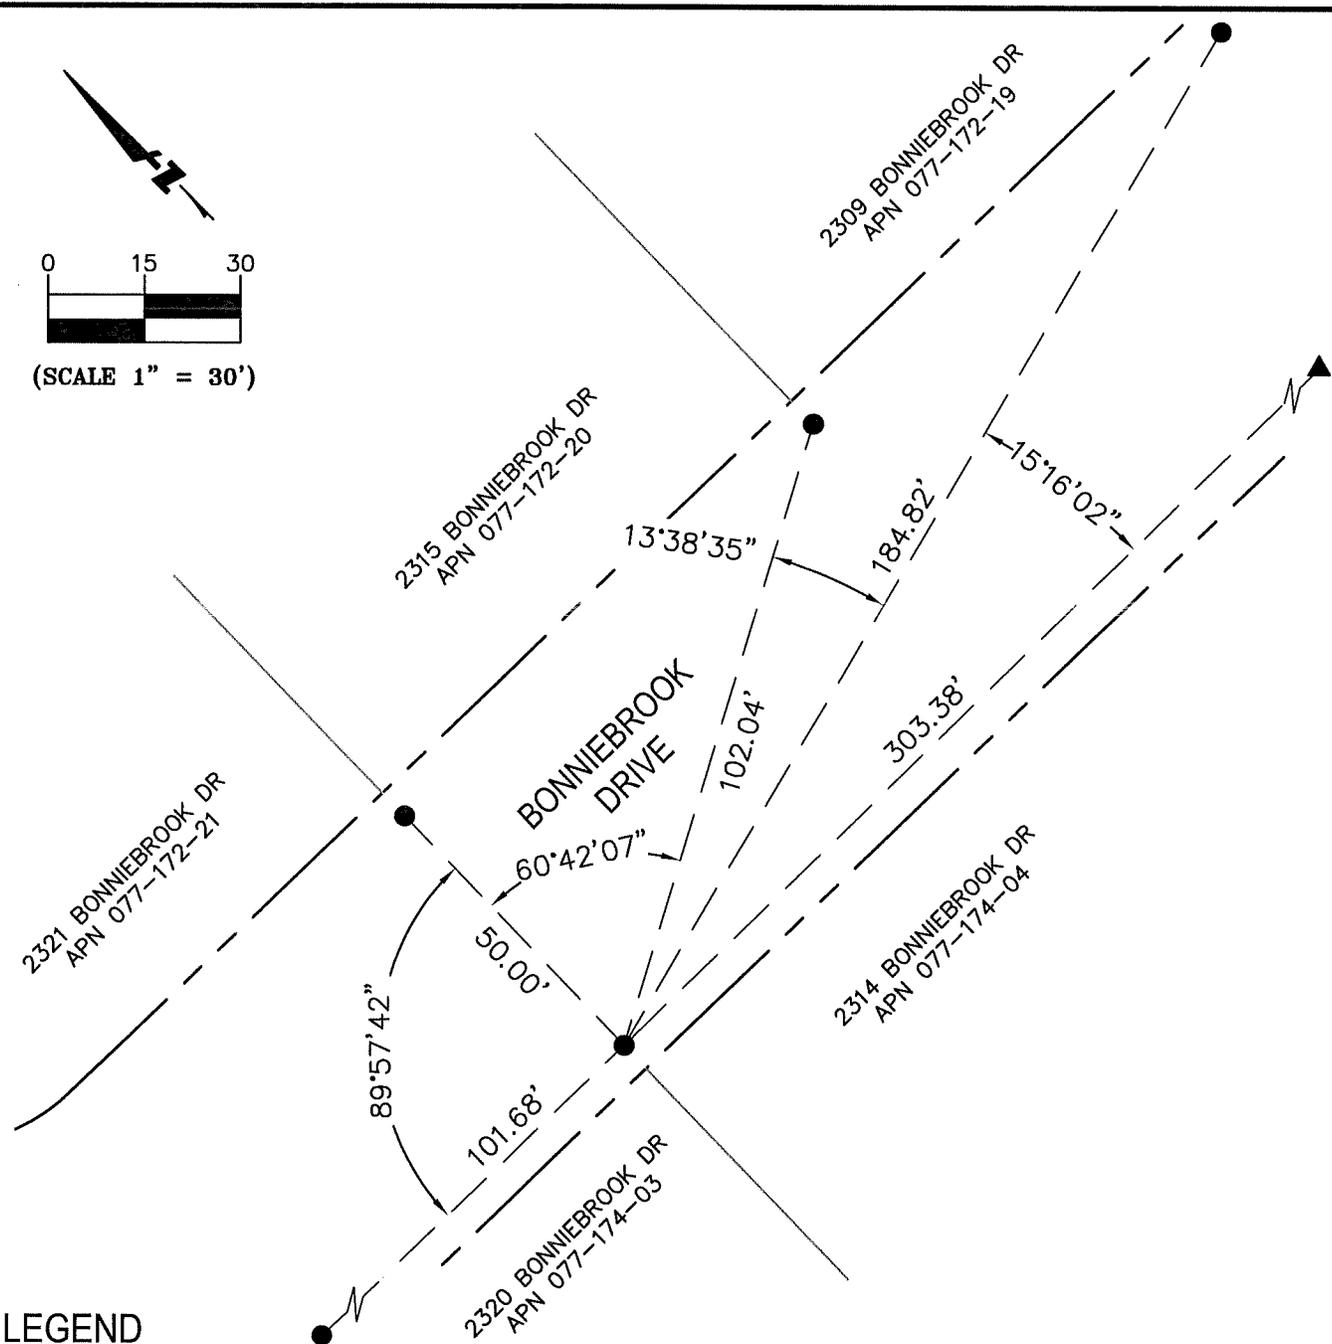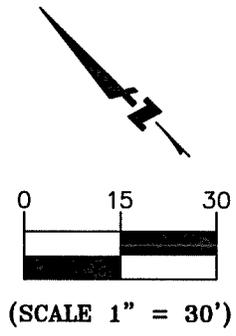

**LEGEND**

- FOUND CUT 'X' IN CONCRETE SIDEWALK, PER CR-25-044, SAN JOAQUIN COUNTY SURVEYOR'S RECORDS
- ▲ FOUND MAG AND WASHER STAMPED "PLS 6868" AT BACK OF ROLLED CURB, PER CR-25-044, SAN JOAQUIN COUNTY SURVEYOR'S RECORDS

APN ASSESSOR'S PARCEL NUMBER  
 CR CORNER RECORD



1730 N. FIRST STREET  
 SUITE 600  
 SAN JOSE, CA 95112  
 408-467-9100  
 www.bkf.com

Subject POST-CONSTRUCTION CORNER RECORD  
AT 2314 & 2320 BONNIEBROOK DRIVE  
 Job No. 20191483-375 - MON PRESERVATION  
 By GA Date 05-12-2025 Chkd. RV  
 SHEET 2 OF 2