

CORNER RECORD

Agency Index CR-25-405
Document Number _____

City of STOCKTON County of SAN JOAQUIN, California
Brief Legal Description COLONEL BROWN COURT, 30 M&P 3

CORNER TYPE

COORDINATES (Optional)



- Government Corner
- Meander
- Rancho
- Control
- Property
- Other

N. _____ E. _____
 Elevation _____
 Units Metric U.S. Survey Foot
 Horizontal Datum _____
 Zone _____ Epoch Date _____
 Vertical Datum _____
 Complies with Public Resources Code §§8801-8819
 Complies with Public Resources Code §§8890-8902

Date of Survey September 28, 2025

T1N., R6E.

- PLS Act Ref.: 8765(d) 8771 8773 Other:
- Corner/Monument: Left as found Established Rebuilt Pre-Construction
 Found and tagged Reestablished Referenced Post-Construction

Narrative of corner identified and monument as found, set, reset, replaced, or removed:
 See sheet #2 for description(s):

FOUND MONUMENTS IN THE CENTERLINE AND PROPERTY LINE OF COLONEL BROWN COURT, 30 M&P 3, SAN JOAQUIN COUNTY RECORDS. See Map on page 2 of this corner record.

SURVEYOR'S STATEMENT

This Corner Record was prepared by me or under my direction in conformance with
 the Professional Land Surveyors' Act on October 1, 2025
 Signed *Ronald E. Monsour* (P.L.S.) or R.C.E. No. 8474




COUNTY SURVEYOR'S STATEMENT

This Corner Record was received November 17, 2025
 and examined and filed November 24, 2025
 Signed *James E. Hart* P.L.S. or R.C.E. No. 8657
 Title County Surveyor



County Surveyor's Comment

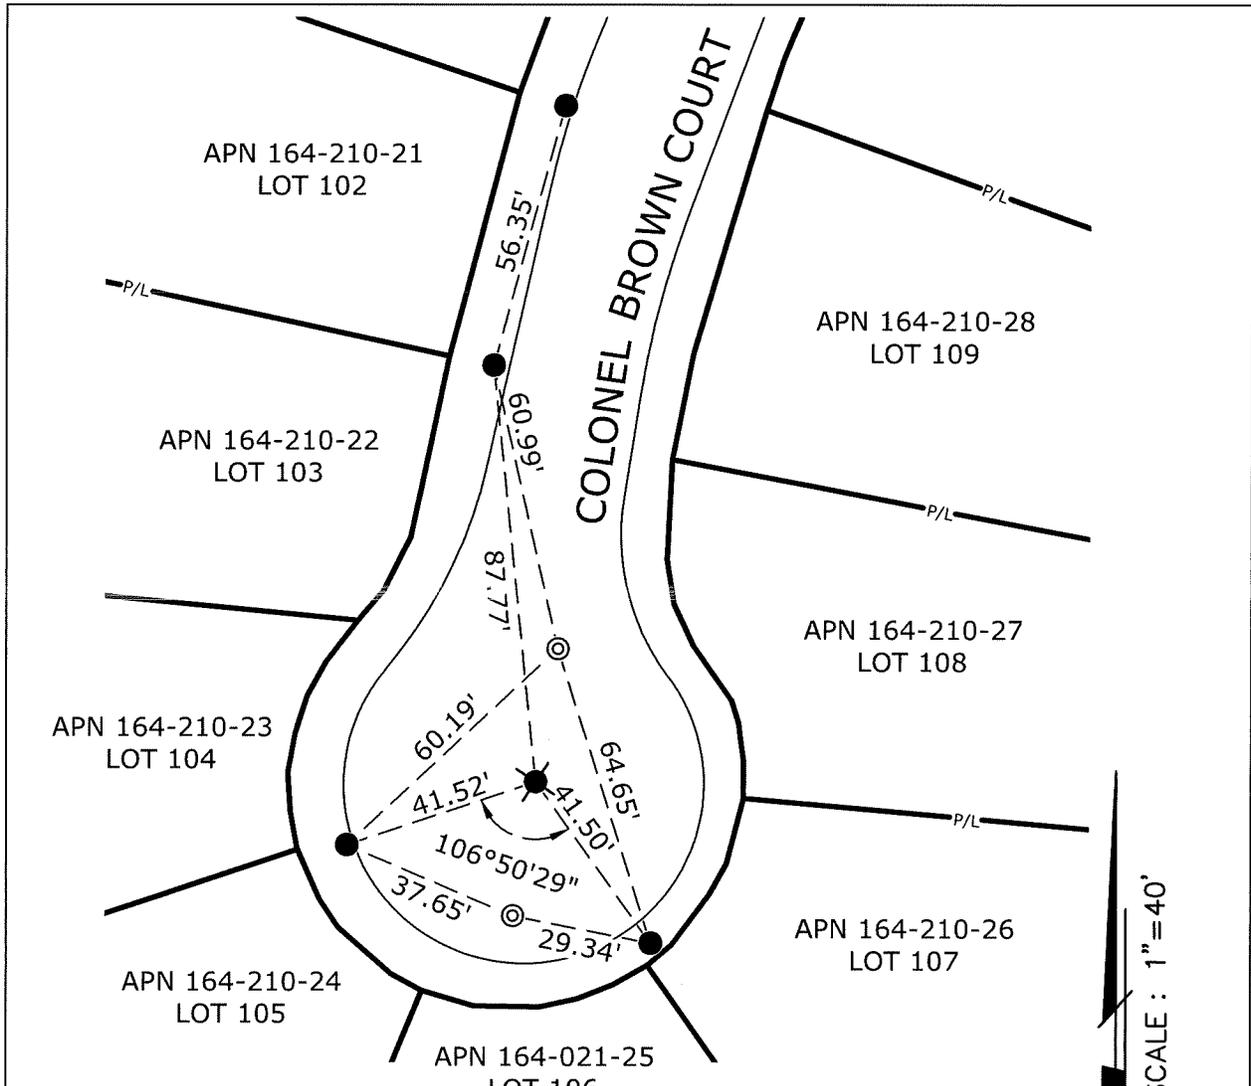


LEGEND:

- -
 -
- S.J.C.R. SAN JOAQUIN COUNTY RECORDS
 APN ASSESSOR'S PARCEL NUMBER
 M&P MAPS & PLATS

REFERENCE:

30 M&P 3, S.J.C.R.

NOTE: THE PURPOSE OF THIS CORNER RECORD IS TO PERPETUATE THE POSITION(S) OF EXISTING MONUMENT(S). NO REPRESENTATION IS MADE TO ANY RELATIVE POSITION(S) OF SAID MONUMENT(S). ALL RIGHT OF WAY, PROPERTY LINES, CENTERLINES AND OTHERS ARE FOR GRAPHICAL REPRESENTATION ONLY.

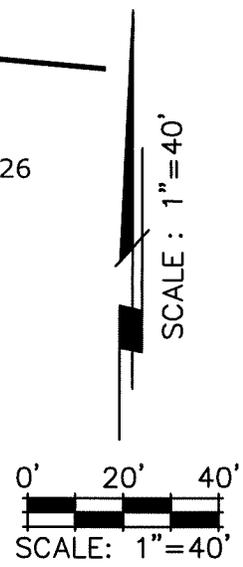

905 Sutter St. Suite 200, Folsom, CA 95630
 (916) 366-3040 Fax: (916) 366-3303
 R.E.Y. ENGINEERS, Inc.
 Civil Engineers / Land Surveyors

**CORNER RECORD
 EXHIBIT MAP**

SCALE: 1" = 40'
JOB NO: 35651152
DATE: 10/14/2025
DWG: 35651152.dwg