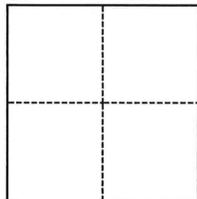


CORNER RECORD

Agency Index CR-25-411

Document Number _____

City of _____ County of San Joaquin, CaliforniaBrief Legal Description The east line of Lot E, shown in Book 10 of Record of Surveys, Page 42**CORNER TYPE****COORDINATES (Optional)**

- Government Corner Control
 Meander Property
 Rancho Other

N. _____ E. _____

Elevation _____

Units Metric U.S. Survey FootHorizontal Datum NAD 83Zone 3 Epoch Date 1991.35

Vertical Datum _____


 Complies with Public Resources Code §§8801-8819 Complies with Public Resources Code §§8890-8902Date of Survey September 25, 2025PLS Act Ref.: 8765(d) 8771 8773 Other:Corner/Monument: Left as found Established Rebuilt Pre-Construction Found and tagged Reestablished Referenced Post-Construction

Narrative of corner identified and monument as found, set, reset, replaced, or removed:

 See sheet #2 for description(s):

This Corner Record is the post-drilling exploration location of found monuments as shown on CR-24-240.

SURVEYOR'S STATEMENTThis Corner Record was prepared by me or under my direction in conformance with the Professional Land Surveyors' Act on November 12, 2025.Signed Brett A. Setness P.L.S. or R.C.E. No. 8265**COUNTY SURVEYOR'S STATEMENT**This Corner Record was received November 12, 2025and examined and filed December 1, 2025.Signed James E. Hart P.L.S. or R.C.E. No. 8657Title County Surveyor**County Surveyor's Comment**

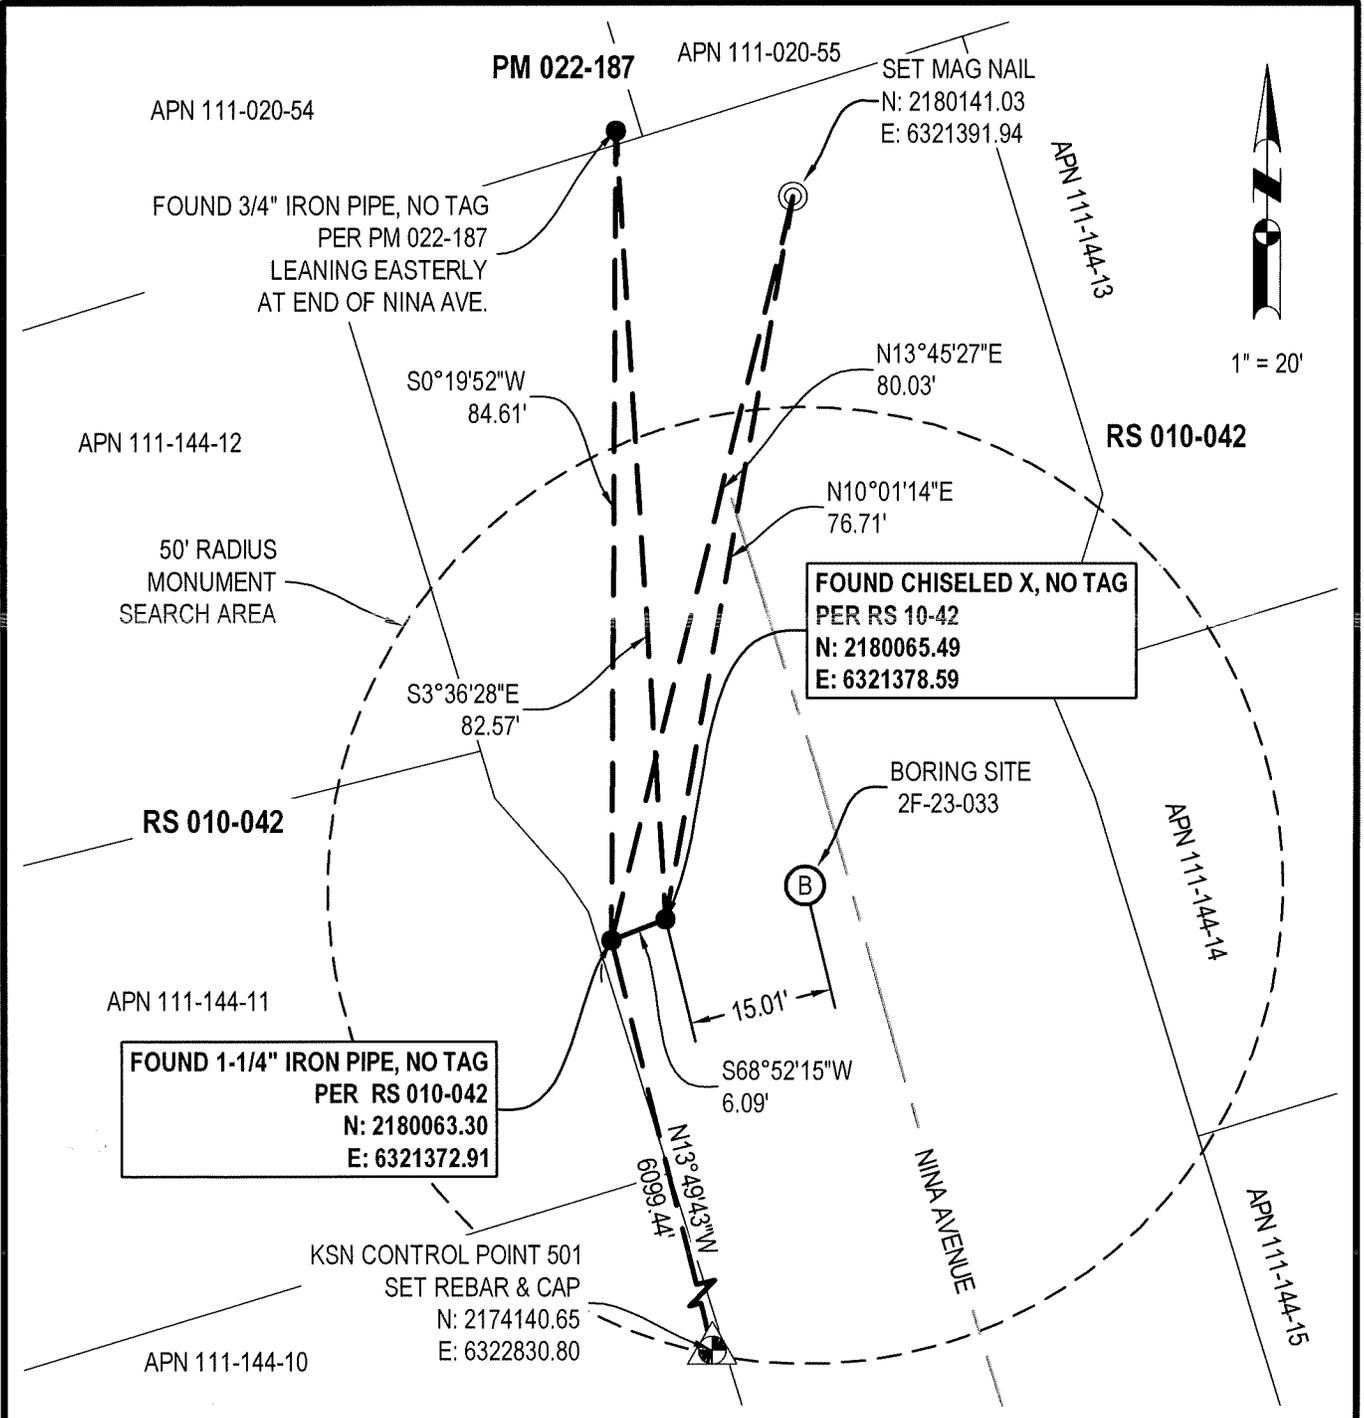

SURVEY CONTROL STATEMENT

COORDINATES, BEARINGS AND DISTANCES SHOWN ARE BASED ON THE NORTH AMERICAN DATUM OF 1983 (NAD 83) CONVERTED TO THE CALIFORNIA COORDINATE SYSTEM OF 1983, ZONE 3 (CCS83-Z3) AS REFERENCED BY AVAILABLE CITY OF STOCKTON AND NGS PUBLISHED CONTROL MONUMENTS. UNITS SHOWN ARE BASED ON THE U.S. SURVEY FOOT, EPOCH DATE 1991.35 ADJUSTMENT. ALL COORDINATES AND DISTANCES ARE GRID, TO CONVERT GRID DISTANCES TO GROUND, MULTIPLY BY 1.00005972. THE CONVERGENCE ANGLE IS -0°30'26". THE CSF WAS DETERMINED AT CONTROL POINT 501.

NOTES:

THIS SURVEY DOES NOT DEFINE BOUNDARY OR RIGHT OF WAY LINES. PARCEL LINES AND ROAD CENTERLINES SHOWN HEREON ARE FOR GENERAL LOCATION AND INFORMATION PURPOSES ONLY TO LOCATE THE PROJECT SITE. SAID LINEWORK IS BASED UPON 1/10/2024 SAN JOAQUIN COUNTY GIS PARCEL DATA.



PM: PARCEL MAP, SAN JOAQUIN COUNTY RECORDS
RS: RECORD OF SURVEY, SAN JOAQUIN COUNTY RECORDS