

CORNER RECORD

Agency Index CR-25-415


Document Number _____

City of UNINCORPORATED AREA County of SAN JOAQUIN, California

Brief Legal Description NE COR. SEC. 1, T.3 N. R.8 E. M.D.B.M.

CORNER TYPE

COORDINATES (Optional)

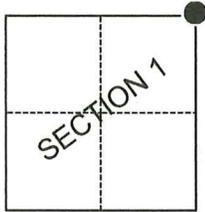

T.3N., R.8E.
M.D.B.&M.

- | | |
|---|-----------------------------------|
| <input checked="" type="checkbox"/> Government Corner | <input type="checkbox"/> Control |
| <input type="checkbox"/> Meander | <input type="checkbox"/> Property |
| <input type="checkbox"/> Rancho | <input type="checkbox"/> Other |

Date of Survey October 17, 2025

N. _____ E. _____

Elevation _____

Units Metric U.S. Survey Foot

Horizontal Datum _____

Zone _____ Epoch Date _____

Vertical Datum _____

Complies with Public Resources Code §§8801-8819

Complies with Public Resources Code §§8890-8902

PLS Act Ref.: 8765(d) 8771 8773 Other:

Corner/Monument: Left as found Established Rebuilt Pre-Construction

Found and tagged Reestablished Referenced Post-Construction

Narrative of corner identified and monument as found, set, reset, replaced, or removed:

See sheet #2 for description(s):

SURVEYOR'S STATEMENT

This Corner Record was prepared by me or under my direction in conformance with

the Professional Land Surveyors' Act on November 4, 2025

Signed *Neil E. Thonesen* P.L.S. or R.C.E. No. 8656



COUNTY SURVEYOR'S STATEMENT

This Corner Record was received November 13, 2025

and examined and filed December 1, 2025


Signed *James E. Hart* P.L.S. or R.C.E. No. 8657

Title County Surveyor

County Surveyor's Comment _____



NORTHEAST COR. SEC. 1, T. 3 N., R. 8 E., MOUNT DIABLO BASE AND MERIDIAN

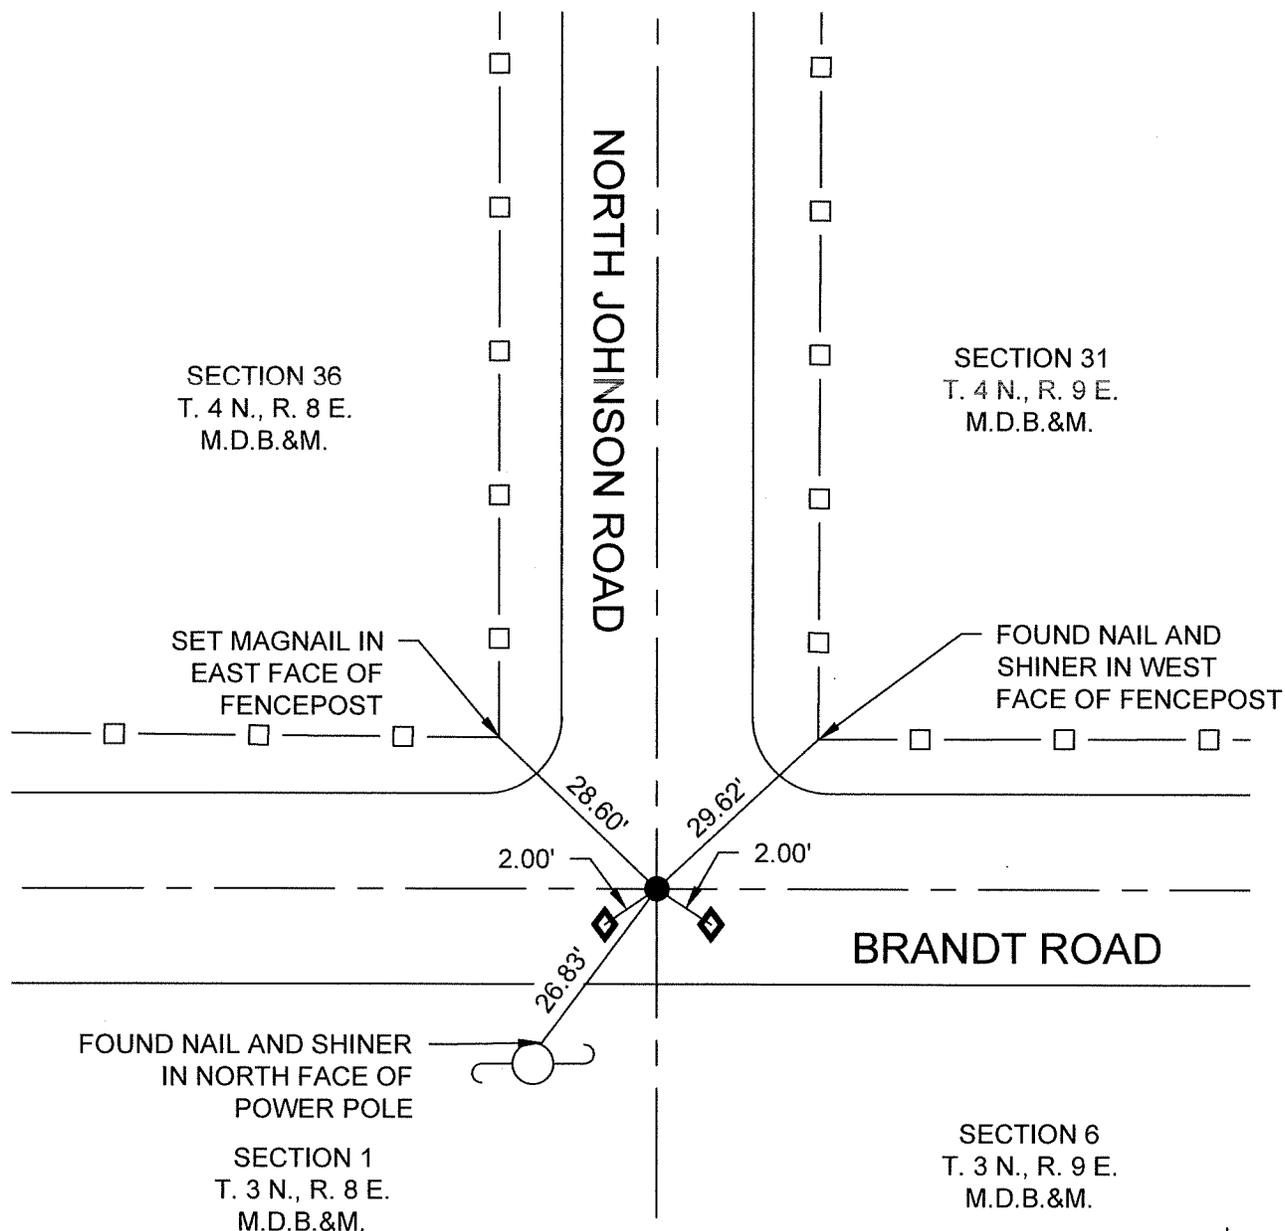

LEGEND

- FOUND CONCRETE MONUMENT WITH SQUARE BRASS PIN , DOWN 20"
- ◆ SET MAGNAIL FLUSH IN ASPHALT



N.T.S.

BASE #25095