


CORNER RECORD

Agency Index CR-25-420

Document Number _____

City of Stockton County of San Joaquin, California

Brief Legal Description Found Monument along a portion of South Aurora Street

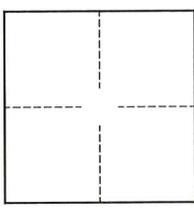

CORNER TYPE

- Government Corner
- Meander
- Rancho
- Control
- Property
- Other

Date of Survey 2025-10-07

COORDINATES (Optional)

N. _____ E. _____

Elevation _____

Units Metric U.S. Survey Foot

Horizontal Datum _____

Zone _____ Epoch Date _____

Vertical Datum _____

Complies with Public Resources Code §§8801-8819

Complies with Public Resources Code §§8890-8902

PLS Act Ref.: 8765(d) 8771 8773 Other: _____

Corner/Monument: Left as found Established Rebuilt Pre-Construction

Found and tagged Reestablished Referenced Post-Construction

Narrative of corner identified and monument as found, set, reset, replaced, or removed:


See sheet #2 for description(s):

Found and set points as shown on page 2. The monument referenced by this document was done so prior to a construction project in the vicinity. No attempt was made to determine the relationship of the monument referenced by this document to property, centerline, or right-of-way lines.

SURVEYOR'S STATEMENT

This Corner Record was prepared by me or under my direction in conformance with the Professional Land Surveyors' Act on _____ November 18, 2025

Signed [Signature] P.L.S. or R.C.E. No. 8040

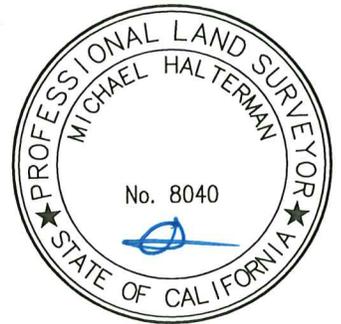

COUNTY SURVEYOR'S STATEMENT

This Corner Record was received December 1, 2025

and examined and filed December 2, 2025

Signed James E. Hart P.L.S. or R.C.E. No. 8657

Title County Surveyor

County Surveyor's Comment _____



SCALE 1" = 30'

APN 149-270-55
635 SOUTH AURORA STREET

APN 151-280-31
935 EAST SCOTTS AVENUE

LEGEND:

- FOUND CHISELED CROSS IN SIDEWALK PER REFERENCE (A)
- SET CUT "X" IN SIDEWALK AS TEMPORARY REFERENCE POINT

REFERENCE:

(A) RECORD OF SURVEY, FILED IN BOOK 38 OF SURVEYS, AT PAGE 11, SAN JOAQUIN COUNTY RECORDS

