

CORNER RECORD

Agency Index CR-25-423


Document Number _____

City of Stockton County of San Joaquin, California

Brief Legal Description Found Monument near intersection of East Hazelton Avenue and South Aurora Street

CORNER TYPE

COORDINATES (Optional)

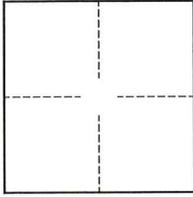

- Government Corner
- Meander
- Rancho
- Control
- Property
- Other

Date of Survey 2025-10-07

N. _____ E. _____

Elevation _____

Units Metric U.S. Survey Foot

Horizontal Datum _____

Zone _____ Epoch Date _____

Vertical Datum _____

Complies with Public Resources Code §§8801-8819

Complies with Public Resources Code §§8890-8902

PLS Act Ref.: 8765(d) 8771 8773 Other:

Corner/Monument: Left as found Established Rebuilt Pre-Construction

Found and tagged Reestablished Referenced Post-Construction

Narrative of corner identified and monument as found, set, reset, replaced, or removed:


See sheet #2 for description(s):

Found and set points as shown on page 2. The monument referenced by this document was done so prior to a construction project in the vicinity. No attempt was made to determine the relationship of the monument referenced by this document to property, centerline, or right-of-way lines.

SURVEYOR'S STATEMENT

This Corner Record was prepared by me or under my direction in conformance with the Professional Land Surveyors' Act on November 18, 2025

Signed [Signature] P.L.S. or R.C.E. No. 8040

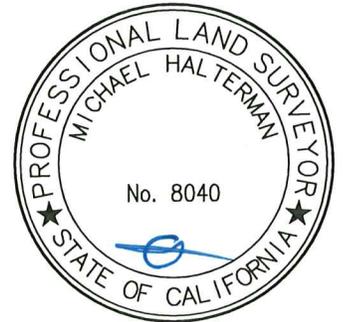

COUNTY SURVEYOR'S STATEMENT

This Corner Record was received December 1, 2025


and examined and filed December 2, 2025

Signed James E. Hart P.L.S. or R.C.E. No. 8657

Title County Surveyor

County Surveyor's Comment



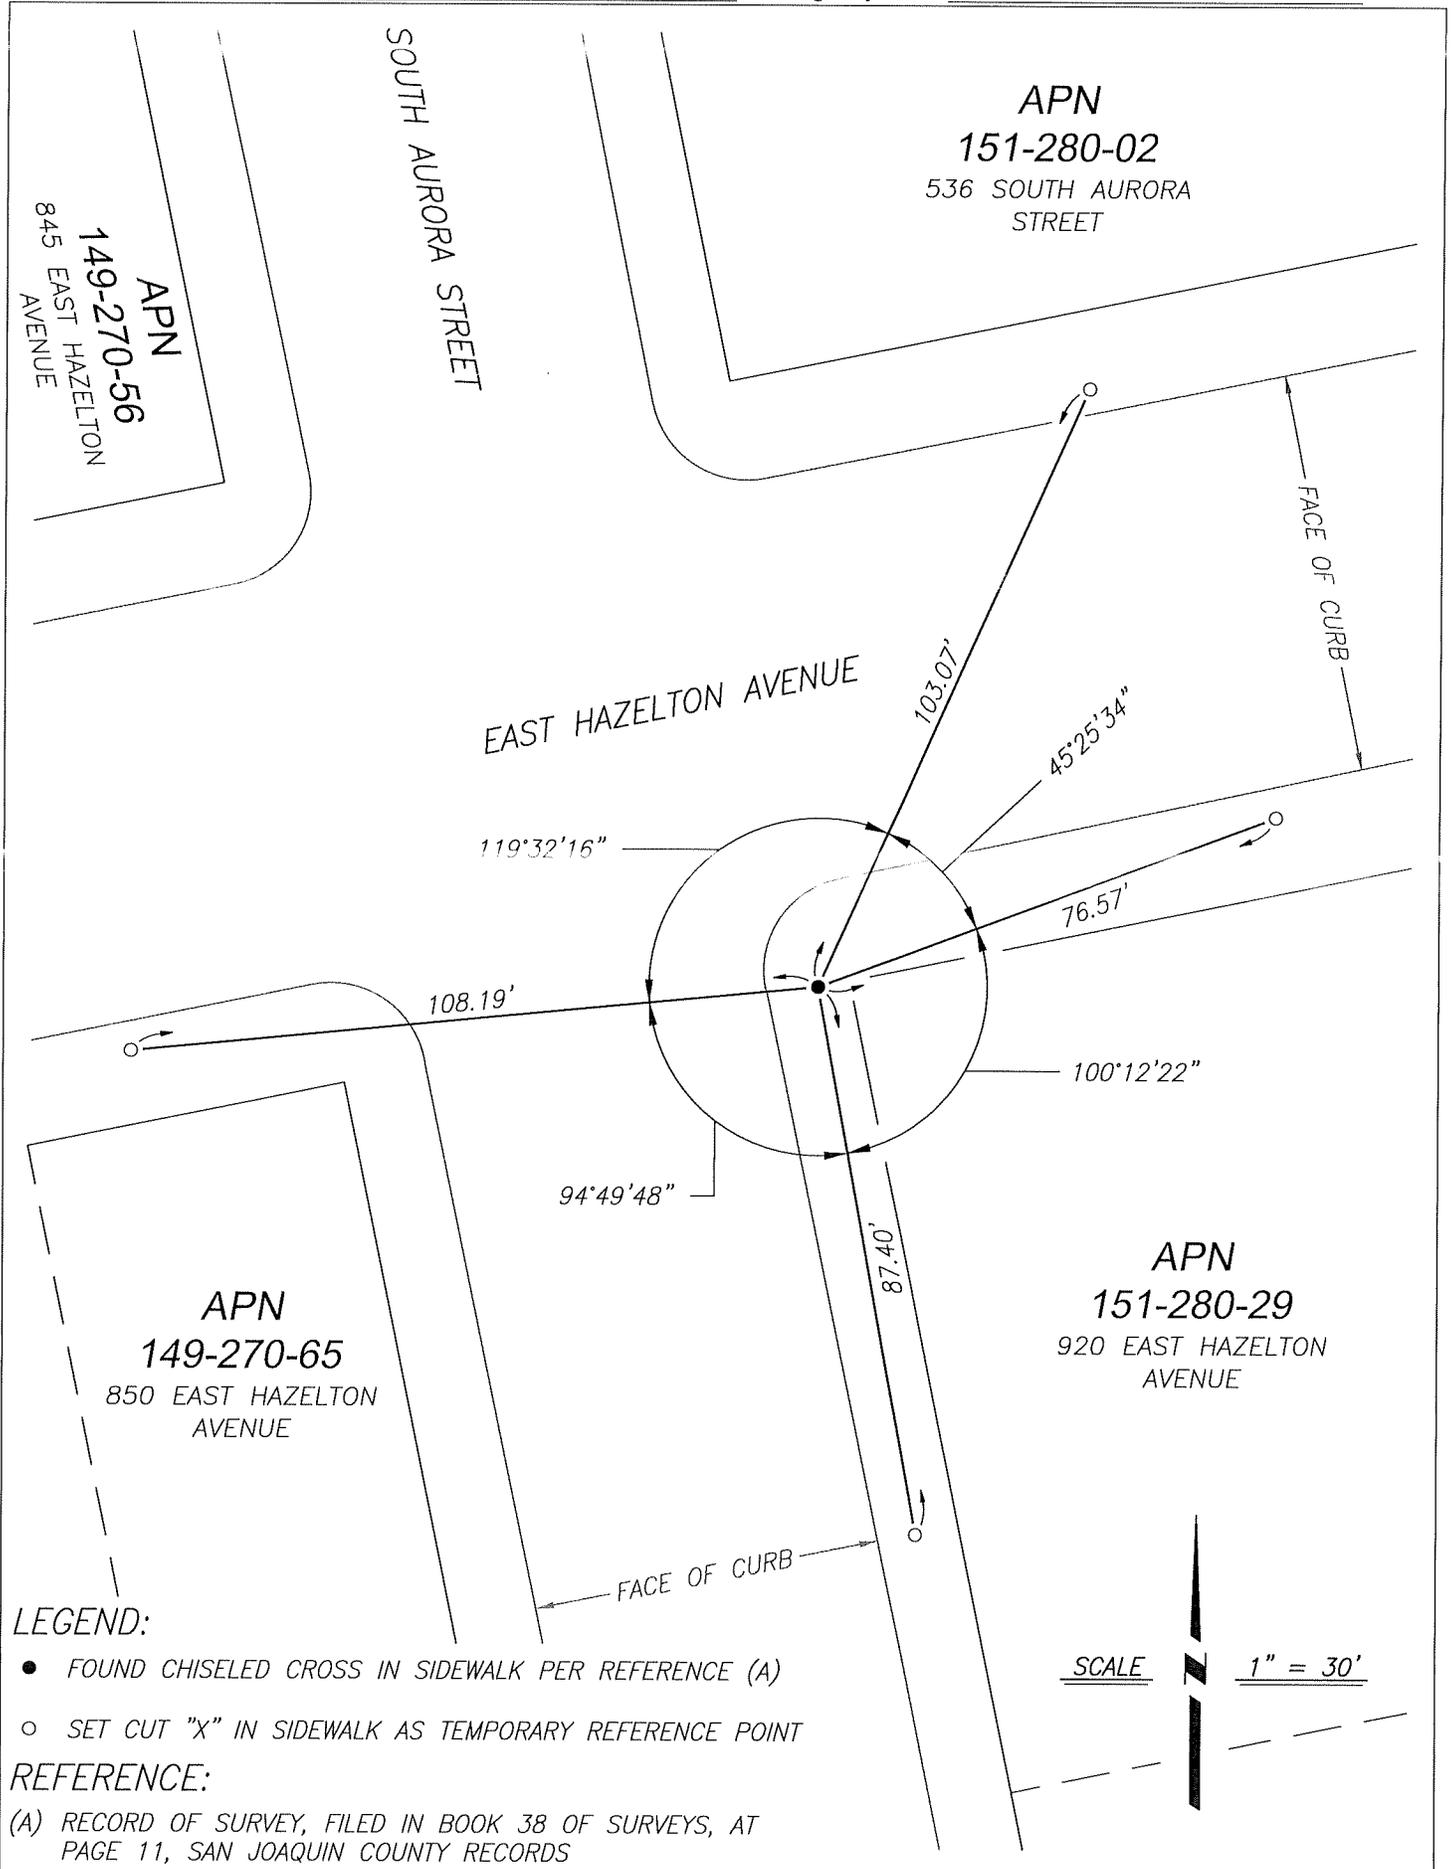

LEGEND:

- FOUND CHISELED CROSS IN SIDEWALK PER REFERENCE (A)
- SET CUT "X" IN SIDEWALK AS TEMPORARY REFERENCE POINT

REFERENCE:

(A) RECORD OF SURVEY, FILED IN BOOK 38 OF SURVEYS, AT PAGE 11, SAN JOAQUIN COUNTY RECORDS

