

CORNER RECORD

Agency Index CR-25-426


Document Number _____

City of UNINCORPORATED County of SAN JOAQUIN, California

Brief Legal Description SECTION CORNER, 32,33,5, & 4, 20 R.S. 110, S.J.C. RECORDS

CORNER TYPE

COORDINATES (Optional)

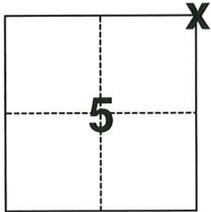

- Government Corner Control
 Meander Property
 Rancho Other

N. _____ E. _____

Elevation _____

Units Metric U.S. Survey Foot

Horizontal Datum _____

Zone _____ Epoch Date _____

Vertical Datum _____

Complies with Public Resources Code §§8801-8819

Complies with Public Resources Code §§8890-8902

Date of Survey October 17, 2025

T 4N., R 5E.

- PLS Act Ref.: 8765(d) 8771 8773 Other:
 Corner/
 Monument: Left as found Established Rebuilt Pre-Construction
 Found and tagged Reestablished Referenced Post-Construction

Narrative of corner identified and monument as found, set, reset, replaced, or removed:

See sheet #2 for description(s):

FOUND BOLT AND WASHER IN THE CENTERLINE OF BLOSSOM ROAD SHOWN AS THE SECTION CORNER OF SECTIONS 32 & 33, T.5N., R.5E. & SECTIONS 5 & 4, T.4N., R.5E. PER 20 R.S. 110, S.J.C. RECORDS.

SURVEYOR'S STATEMENT

This Corner Record was prepared by me or under my direction in conformance with the Professional Land Surveyors' Act on October 21, 2025.
 Signed Ronald E. Mousour (P.L.S. or R.C.E. No. 8474)




COUNTY SURVEYOR'S STATEMENT

This Corner Record was received November 25, 2025 and examined and filed December 2, 2025.
 Signed James E. Hart P.L.S. or R.C.E. No. 8657
 Title County Surveyor



County Surveyor's Comment

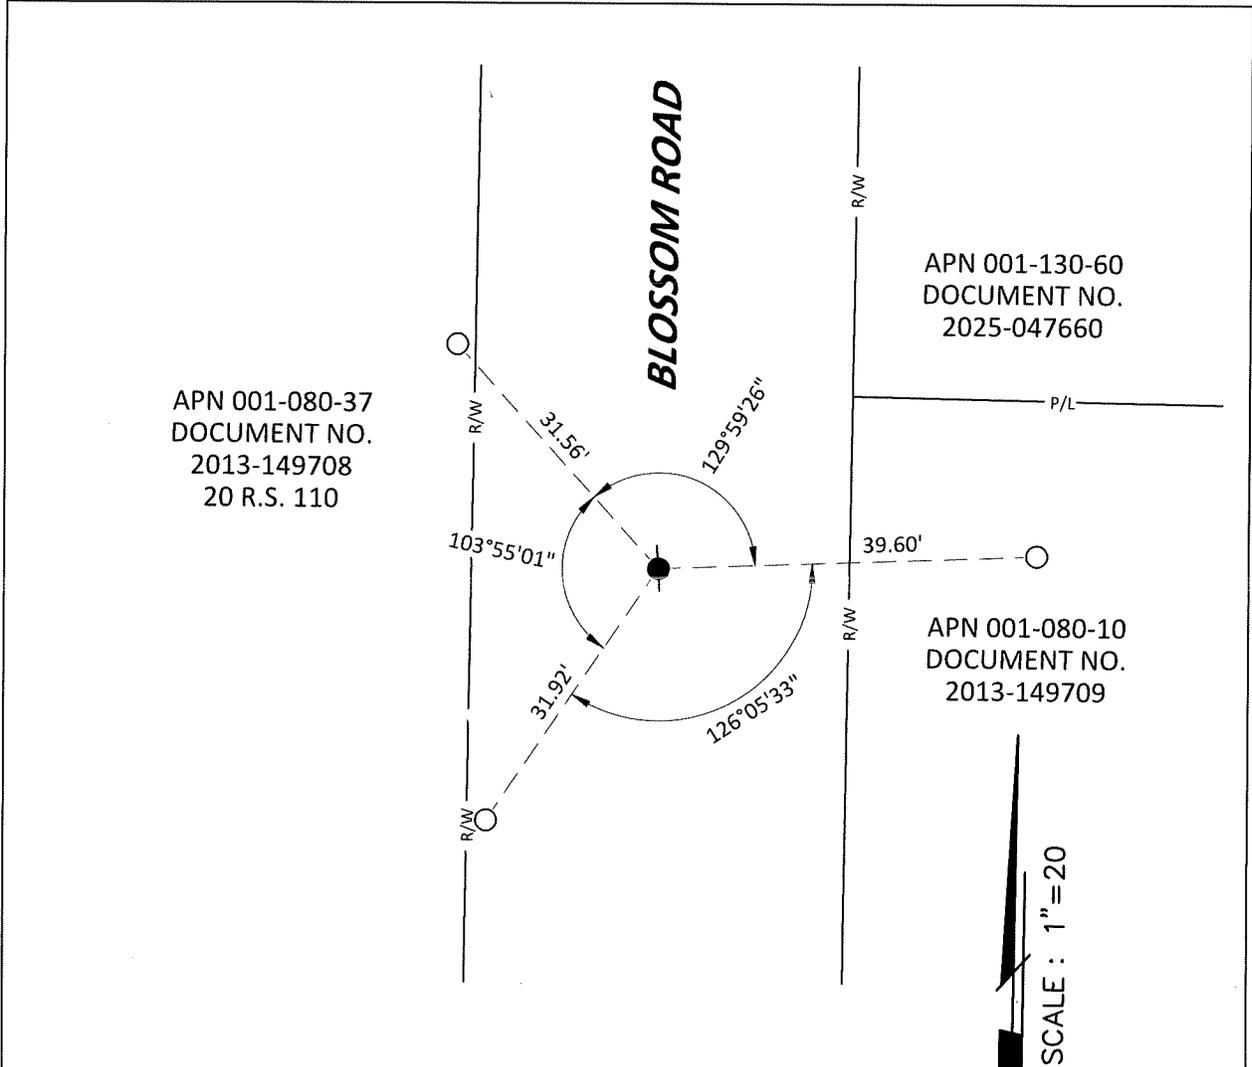

LEGEND:


-  FOUND BOLT HEAD WITH WASHER
-  SET 5/8" REBAR WITH CAP

S.J.C.R. SAN JOAQUIN COUNTY RECORDS
 APN ASSESSOR'S PARCEL NUMBER
 R.S. RECORD OF SURVEY

REFERENCE(S):

20 R.S. 110, S.J.C.R.

NOTE:
 THE PURPOSE OF THIS CORNER RECORD IS TO PERPETUATE THE POSITION(S) OF EXISTING MONUMENT(S). NO REPRESENTATION IS MADE TO ANY RELATIVE POSITION(S) OF SAID MONUMENT(S). ALL RIGHT OF WAY, PROPERTY LINES, CENTERLINES AND OTHERS ARE FOR GRAPHICAL REPRESENTATION ONLY.

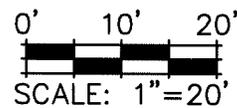

905 Sutter St. Suite 200, Folsom, CA 95630
 (916) 366-3040 Fax (916) 366-3303
 R.E.Y. ENGINEERS, Inc.
 Civil Engineers / Land Surveyors

**CORNER RECORD
 EXHIBIT MAP**

SCALE: 1"=20'
JOB NO: 47280119
DATE: 10/21/2025
DWG: BLOSSOM ROAD