


CORNER RECORD

Agency Index CR-25-428
 Document Number _____

City of Tracy County of San Joaquin, California
 Brief Legal Description Section 25, Township 2 South, Range 4 East, Mount Diablo Base & Meridian

CORNER TYPE

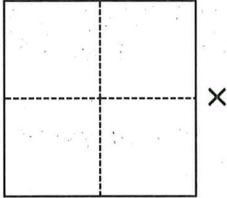

- Government Corner Control
 Meander Property
 Rancho Other

Date of Survey October 7, 2025

COORDINATES (Optional)

N. _____ E. _____
 Elevation _____
 Units Metric U.S. Survey Foot
 Horizontal Datum NAD83
 Zone 3 Epoch Date _____
 Vertical Datum _____
 Complies with Public Resources Code §§8801-8819
 Complies with Public Resources Code §§8890-8902

PLS Act Ref.: 8765(d) 8771 8773 Other:
 Corner/Monument: Left as found Established Rebuilt Pre-Construction
 Found and tagged Reestablished Referenced Post-Construction

Narrative of corner identified and monument as found, set, reset, replaced, or removed:

See sheet #2 for description(s):

The East quarter corner of Section 25, as shown on the Parcel Map filed for record on August 14, 2006, in Book 24 of Parcel Maps at Page 23, San Joaquin County Records.
 Said monument is shown as a 3/4 inch iron pipe on the Parcel Map, we found a 2 inch iron pipe. Said monument is in danger of being disturbed by construction and is described as follows
 2 inch iron pipe, not capped.

SURVEYOR'S STATEMENT

This Corner Record was prepared by me or under my direction in conformance with
 the Professional Land Surveyors' Act on December 10, 2025
 Signed [Signature] P.L.S. or R.C.E. No. 9032





COUNTY SURVEYOR'S STATEMENT

This Corner Record was received December 10, 2025
 and examined and filed December 18, 2025
 Signed James E. Hart P.L.S. or R.C.E. No. 8657
 Title County Surveyor



County Surveyor's Comment

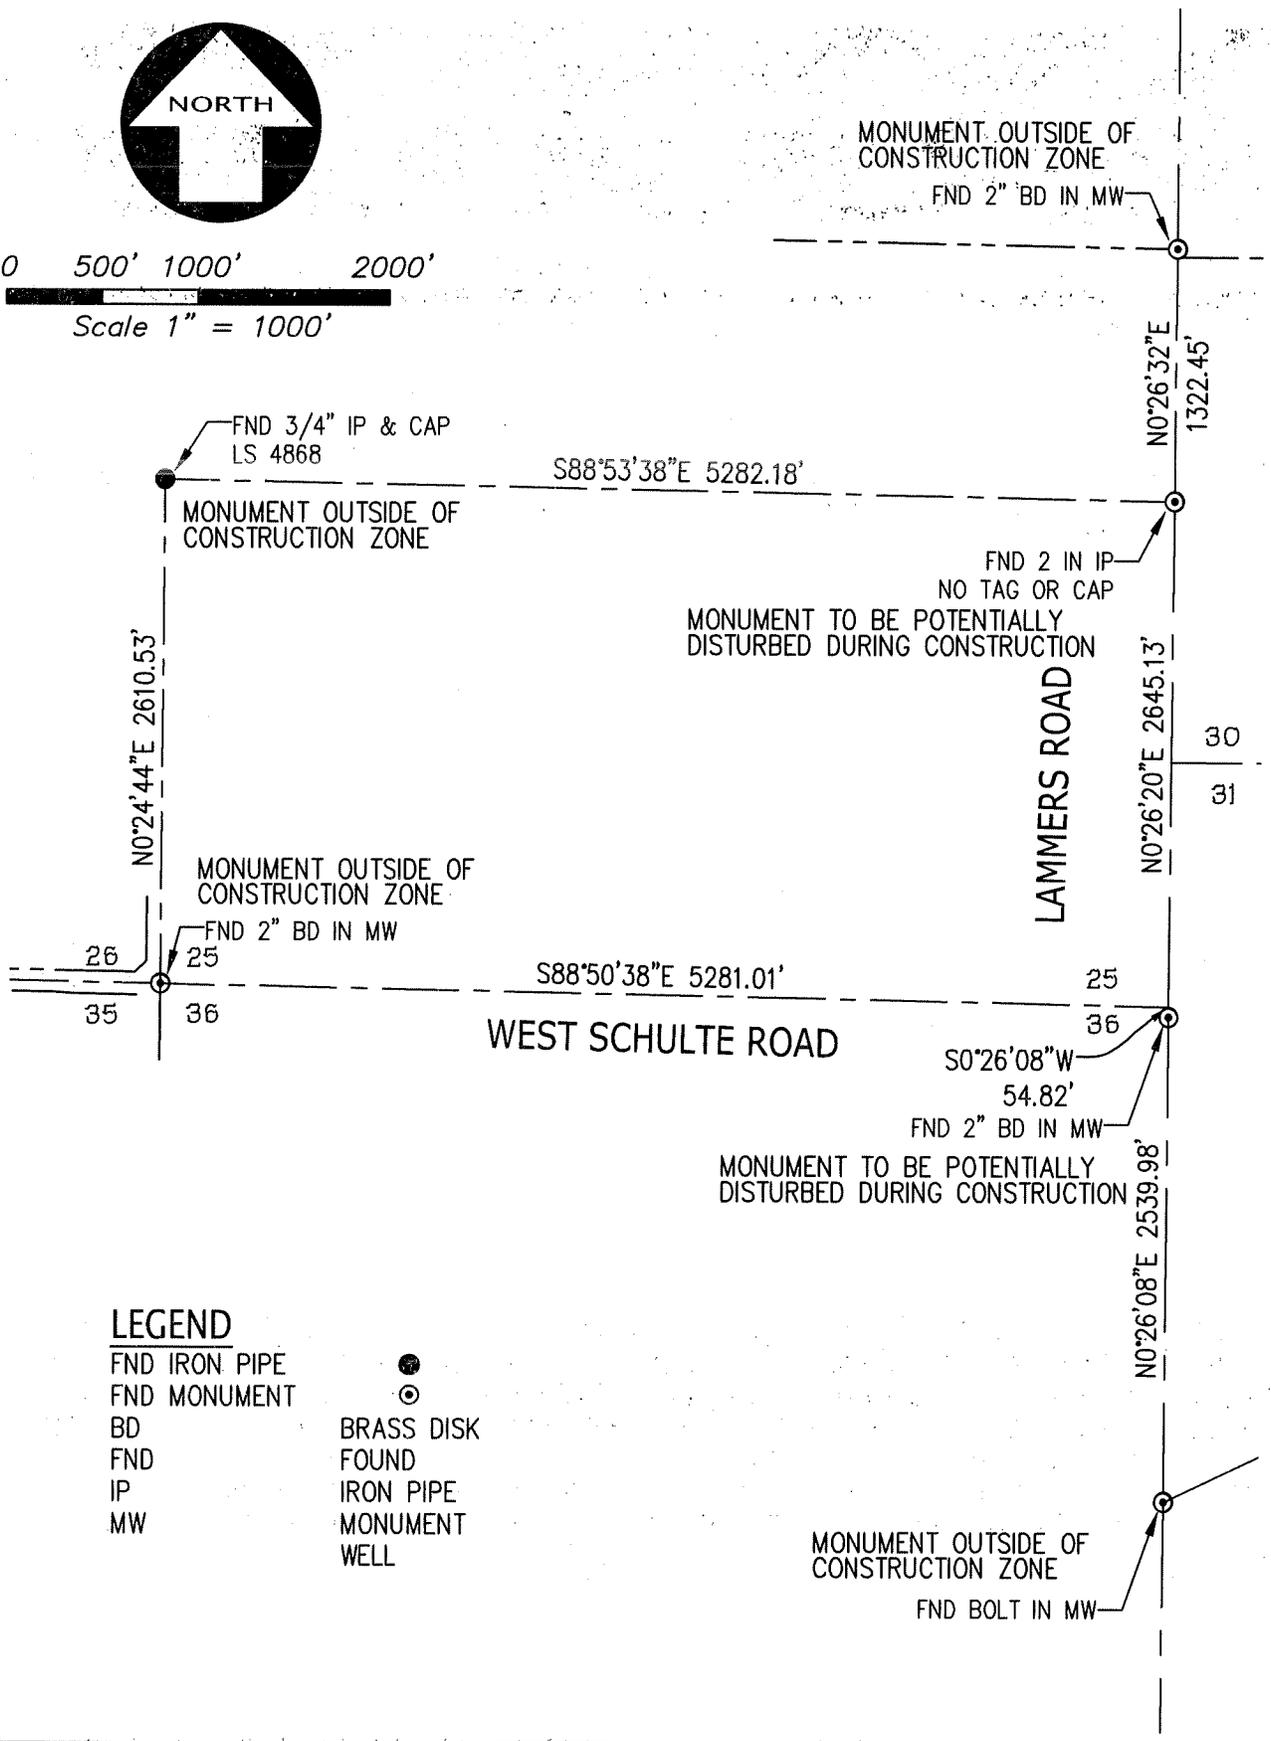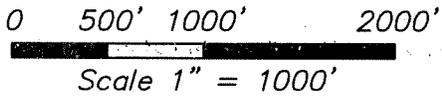

LEGEND

- | | |
|---------------|---------------|
| FND IRON PIPE | ● |
| FND MONUMENT | ⊙ |
| BD | BASS DISK |
| FND | FOUND |
| IP | IRON PIPE |
| MW | MONUMENT WELL |