


CORNER RECORD

Agency Index CR-25-429

Document Number _____

City of Tracy County of San Joaquin, California

Brief Legal Description Section 36, Township 2 South, Range 4 East, Mount Diablo Base & Meridian

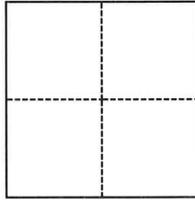	CORNER TYPE	COORDINATES (Optional)
	<input type="checkbox"/> Government Corner <input type="checkbox"/> Control <input type="checkbox"/> Meander <input type="checkbox"/> Property <input type="checkbox"/> Rancho <input checked="" type="checkbox"/> Other	N. _____ E. _____ Elevation _____ Units <input type="checkbox"/> Metric <input checked="" type="checkbox"/> U.S. Survey Foot Horizontal Datum <u>NAD83</u> Zone <u>3</u> Epoch Date _____ Vertical Datum _____ <input type="checkbox"/> Complies with Public Resources Code §§8801-8819 <input type="checkbox"/> Complies with Public Resources Code §§8890-8902
Date of Survey <u>October 7, 2025</u>		

PLS Act Ref.:	<input type="checkbox"/> 8765(d)	<input checked="" type="checkbox"/> 8771	<input type="checkbox"/> 8773	<input type="checkbox"/> Other:
Corner/ Monument:	<input checked="" type="checkbox"/> Left as found	<input type="checkbox"/> Established	<input type="checkbox"/> Rebuilt	<input checked="" type="checkbox"/> Pre-Construction
	<input type="checkbox"/> Found and tagged	<input type="checkbox"/> Reestablished	<input type="checkbox"/> Referenced	<input type="checkbox"/> Post-Construction

Narrative of corner identified and monument as found, set, reset, replaced, or removed:
 See sheet #2 for description(s):
 The corner as shown on the Final Map, Tract No. 2848 filed for record on December 30, 1999, in Book 34 of Maps and Plats at Page 83, San Joaquin County Records.
 Said monument is in danger of being disturbed by construction and is described as follows
 2 inch brass disk in monument well, not stamped.

SURVEYOR'S STATEMENT

This Corner Record was prepared by me or under my direction in conformance with
 the Professional Land Surveyors' Act on December 10, 2025
 Signed [Signature] P.L.S. or R.C.E. No. 9032



COUNTY SURVEYOR'S STATEMENT

This Corner Record was received December 10, 2025
 and examined and filed December 18, 2025
 Signed James E. Hart P.L.S. or R.C.E. No. 8657
 Title County Surveyor




County Surveyor's Comment



0 500' 1000' 2000'



Scale 1" = 1000'

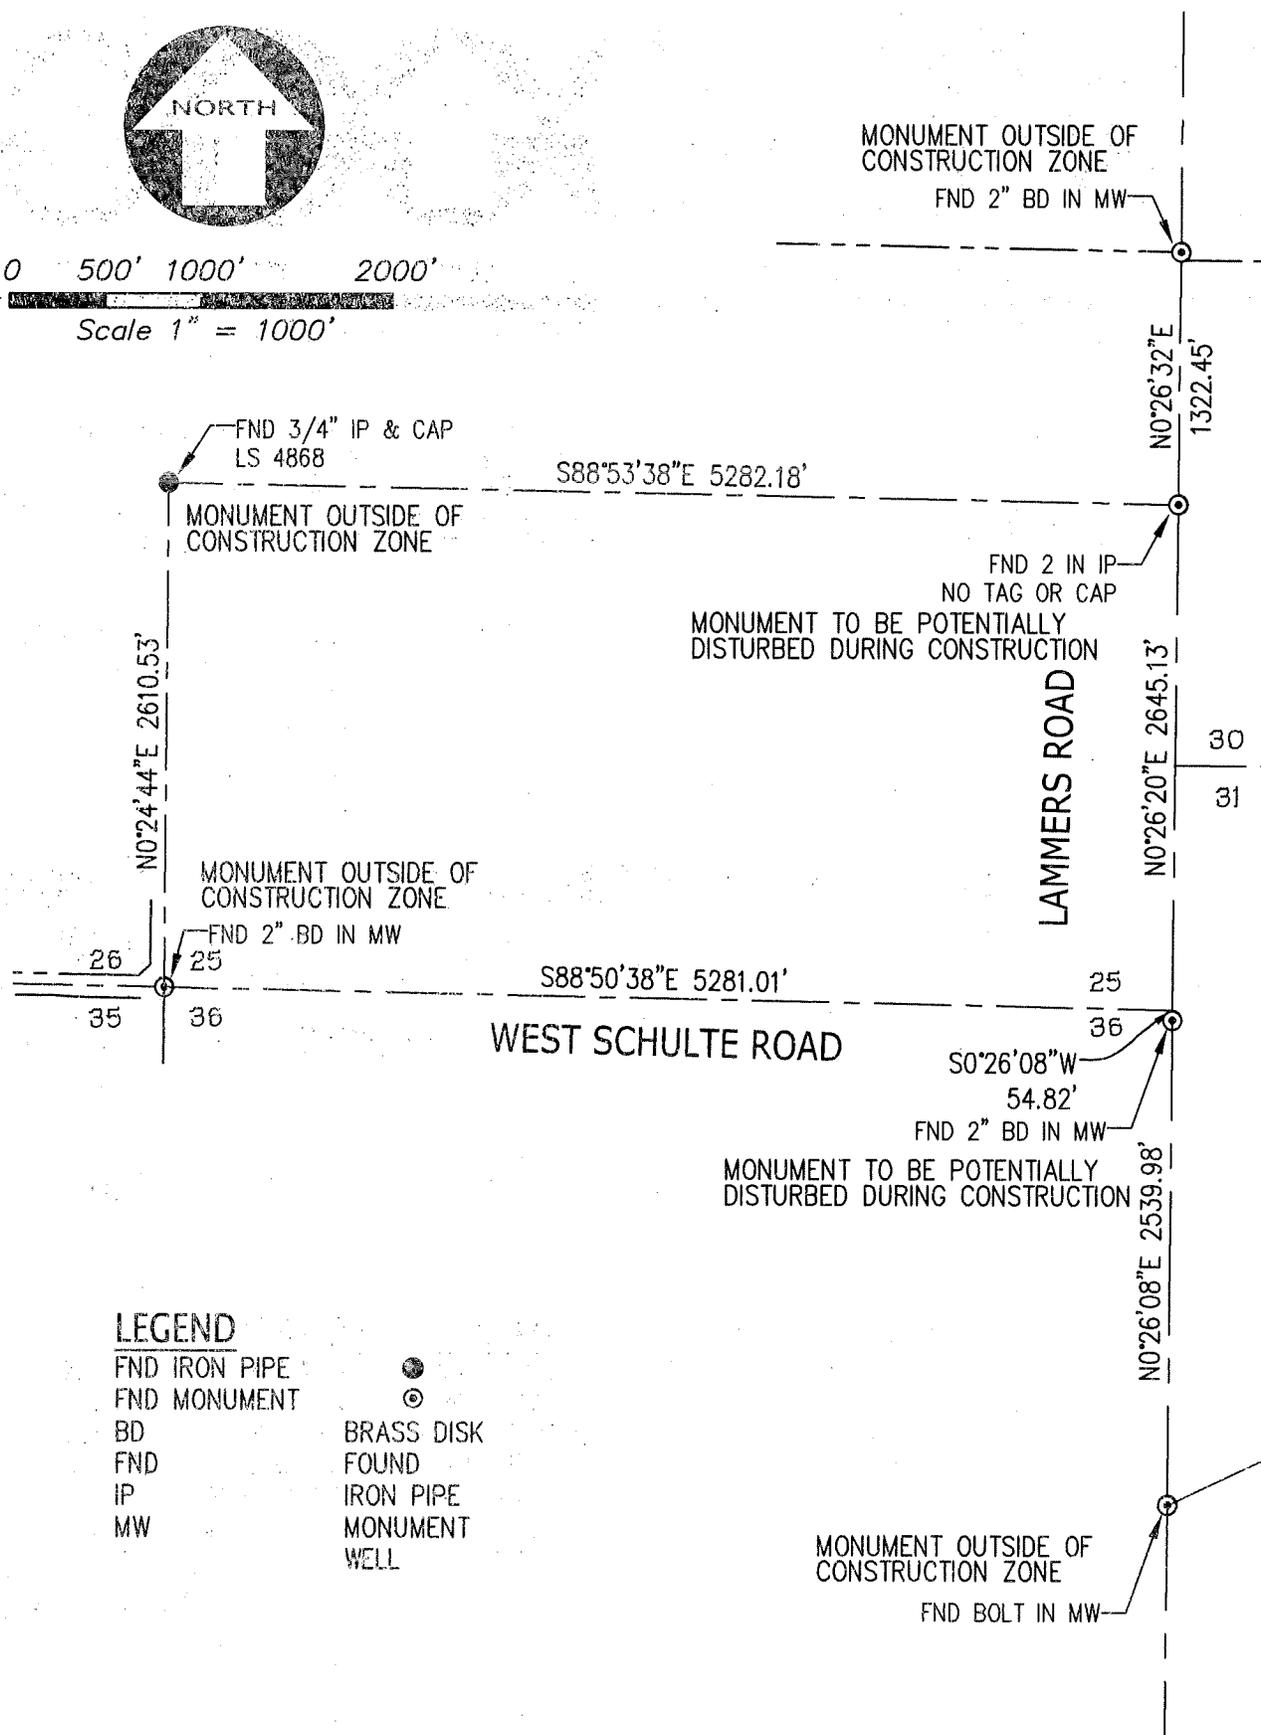

LEGEND

- | | |
|---------------|---------------|
| FND IRON PIPE | ● |
| FND MONUMENT | ⊙ |
| BD | BRASS DISK |
| FND | FOUND |
| IP | IRON PIPE |
| MW | MONUMENT WELL |